

Harrison  
G-122  
4-68 **CODED**

MISSISSIPPI  
 BOARD OF WATER COMMISSIONERS  
 416 North State Street  
 Jackson, Mississippi 39201

**CODED**

WATER WELL DRILLERS LOG

April 18 1968 Rabin's Well Works Harrison  
 date well completed firm name county well located

LANDOWNER: Alan Smith  
Deleaux  
Gulfport Miss  
 (mailing address)

description of formations encountered	from	to
<u>Red Sand &amp; Clay</u>	<u>0</u>	<u>20</u>
<u>Blue Sand</u>	<u>30</u>	<u>302</u>


WELL LOCATION:  
 sec 24 T 6 N R 11 E  
~~1/2~~ 1/2 miles North of Gulfport  
 (distance) (direction) (nearest town)

WELL PURPOSE: Home  
 (home, irrigation, municipal, industrial)

WELL COMPLETION DATA:

- (1) diameter (inches) 2 inch
- (2) total depth (feet) 202
- (3) static water level (feet) Above below above top of ground.
- (4) casing 2 inch, 192,  
 (material) (depth)  
2 inch if telescope see back.  
 (size)
- (5) screen 10, 192  
 (length) (depth to top)  
008, Stainless steel  
 (size) (material)
- (6) pump 1/2 12  
 (HP) (yield gpm)  
Elec  
 (type power)
- (7) electric log No  
 (yes or no)  
 (organization running log)
- (8) how well bottom plugged Back  
wash valve


**CODED**

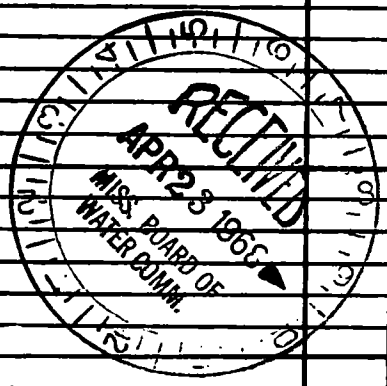

DRILLERS REMARKS:

If well telescopes please sketch and show depths.

GROUND LEVEL

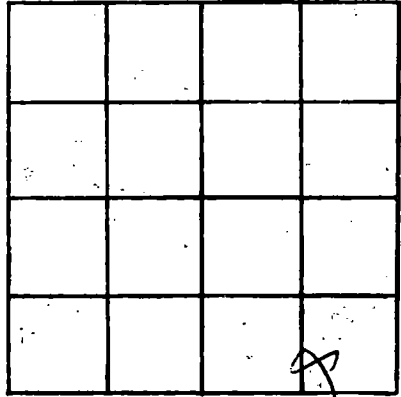

SECTION 28

Please indicate well location X.

ADDITIONAL INFORMATION

If more than one screen, show locations of each on sketch.