

Harrison
G123
3-68

MISSISSIPPI
 BOARD OF WATER COMMISSIONERS
 416 North State Street
 Jackson, Mississippi 39201
 WATER WELL DRILLERS LOG

CODED

March 8 1968 Ladner Well Works Harrison
 date well completed firm name county well located

LANDOWNER: L. N. Fonto Jr.
John Clark Road
Lyman Miss
 (mailing address)

description of formations encountered	from to	
	feet	feet
<u>Red clay sand</u>	<u>0</u>	<u>90</u>
<u>Blue sand</u>	<u>90</u>	<u>235</u>


WELL LOCATION:
 sec 29 T 6 N R 11 E
6 miles West of Lyman
 (distance) (direction) (nearest town)

CODED

WELL PURPOSE: Home
 (home, irrigation, municipal, industrial)

WELL COMPLETION DATA:


- (1) diameter (inches) 2 inch
- (2) total depth (feet) 233
- (3) static water level (feet) 60 below above top of ground.
- (4) casing 2 inch, 223,
 (material) (depth)
2 inch if telescope see back.
 (size)
- (5) screen 10, 223
 (length) (depth to top)
009, Stainless steel
 (size) (material)
- (6) pump 1 20
 (HP) (yield gpm)
Elec
 (type power)
- (7) electric log No
 (yes or no)
 (organization running log)
- (8) how well bottom plugged Back
Wash Valve

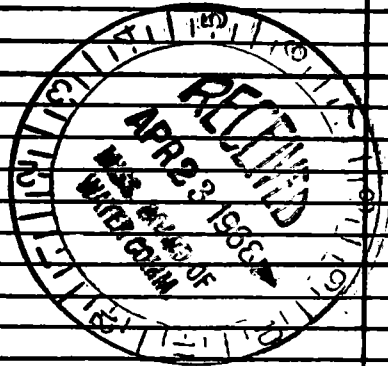

DRILLERS REMARKS:

If well telescopes please sketch and show depths.

GROUND LEVEL

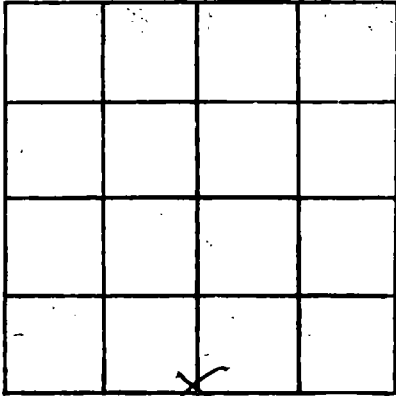

SECTION 29

Please indicate well location X.

ADDITIONAL INFORMATION

If more than one screen, show locations of each on sketch.