

Harrison
 G 124
 4-68 **CODED**

MISSISSIPPI
 BOARD OF WATER COMMISSIONERS
 416 North State Street
 Jackson, Mississippi 39201

CODED

WATER WELL DRILLERS LOG

April 10 1968 Ladner Well Works Harrison
 date well completed firm name county well located

LANDOWNER: Jimmy Moran
John Clark Road.
 (mailing address)

description of formations encountered	from	to
<u>Red clay & sand</u>	<u>0</u>	<u>60</u>
<u>Blue clay & sand</u>	<u>60</u>	<u>486</u>

WELL LOCATION:
 sec. 29 to N R 11 E
2 1/2 miles Southwest of Lyman
 (distance) (direction) (nearest town)

WELL PURPOSE: Home
 (home, irrigation, municipal, industrial)


WELL COMPLETION DATA:

- (1) diameter (inches) 2 inch
 - (2) total depth (feet) 486
 - (3) static water level (feet) 20 ^{below}/_{above} top of ground.
 - (4) casing 2 inch, 476.
 (material) (depth)
2 inch if telescope see back.
 (size)
 - (5) screen 10, 476
 (length) (depth to top)
008, Stainless steel
 (size) (material)
 - (6) pump 1/2 12
 (HP) (yield gpm)
Elec
 (type power)
 - (7) electric log no
 (yes or no)
- (organization running log)

CODED


(8) how well bottom plugged Back
Wash valve

DRILLERS REMARKS:

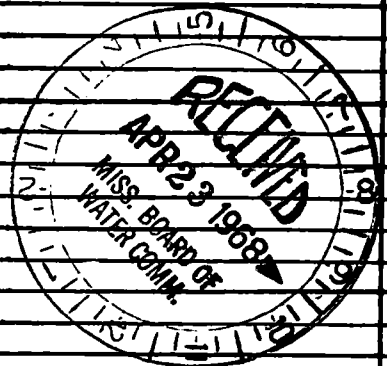

If well telescopes please sketch and show depths.

GROUND LEVEL

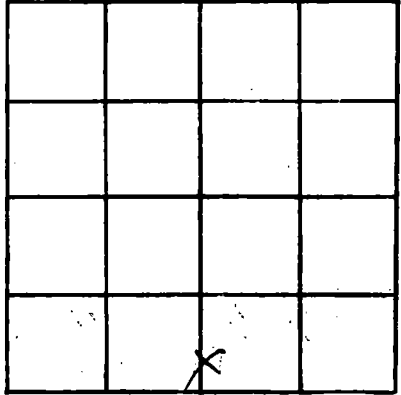

SECTION 29

Please indicate well location X.

ADDITIONAL INFORMATION

If more than one screen, show locations of each on sketch.