

7

MISSISSIPPI  
BOARD OF WATER COMMISSIONERS  
416 North State Street  
Jackson, Mississippi 39201

WATER WELL DRILLERS LOG

**CODED**

Harrison  
G125  
1-68

**CODED**

Jan 17 1968 date well completed  
Ladwin Well Works firm name  
Harrison county well located

LANDOWNER: Jack Lee  
Lambert Rd.  
Gulfport, Miss.  
(mailing address)

description of formations encountered	from to	
	feet	feet
yellow sand & clay	0	80
Blue clay	80	303
Blue sand	406	

WELL LOCATION:  
sec. 32-6 N R-11 E  
6 miles north of Gulfport  
(distance) (direction) (nearest town)

WELL PURPOSE: Home  
(home, irrigation, municipal, industrial)

WELL COMPLETION DATA:

- (1) diameter (inches) 2 inch
- (2) total depth (feet) 423
- (3) static water level (feet) 20 <sup>below</sup>/<sub>above</sub> top of ground.
- (4) casing 2 inch, 413  
(material) (depth)  
2 inch (size) If telescope see back.
- (5) screen 10 ft., 413  
(length) (depth to top)  
008, Stainless Steel  
(size) (material)
- (6) pump 1 (HP) 20 (yield gpm)  
Elec (type power)
- (7) electric log No. (yes or no)
- (organization running log)
- (8) how well bottom plugged Back Wash Valve

**CODED**


**CODED**



DRILLERS REMARKS:

If well telescopes please sketch and show depths.

GROUND LEVEL

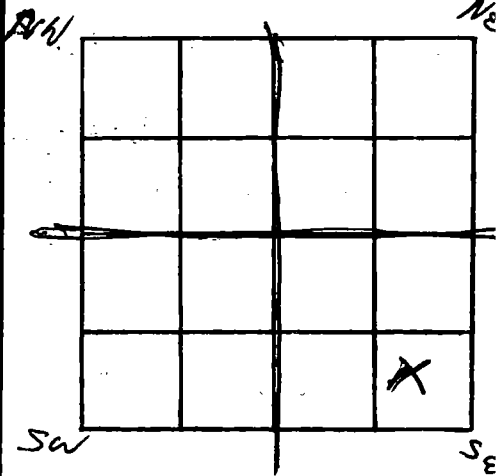

SECTION 32

Please indicate well location X.

ADDITIONAL INFORMATION

If more than one screen, show locations of each on sketch.