

Harrison  
 G126  
 4-68

MISSISSIPPI  
 BOARD OF WATER COMMISSIONERS  
 416 North State Street  
 Jackson, Mississippi 392

**CODED**

WATER WELL DRILLERS LOG

April 19 68 Coastal Driller Harris  
 date well completed firm name county well located

LANDOWNER: Ray Adams  
 Rt 13 365  
 Eggt, Miss  
 (mailing address)

WELL LOCATION:  
 sec. 33 T. 6 N. R. 11 E  
2 1/2 miles SW of LYMAN  
 (distance) (direction) (nearest town)

WELL PURPOSE: home  
 (home, irrigation, municipal, industrial)

WELL COMPLETION DATA:

- (1) diameter (inches) 2
- (2) total depth (feet) 420
- (3) static water level (feet) \_\_\_\_\_ below top of ground.
- (4) casing galv 420  
 (material) (depth)  
 \_\_\_\_\_ If telescope see back.  
 (size)
- (5) screen 10' \_\_\_\_\_  
 (length) (depth to top)  
2 35  
 (size) (material)
- (6) pump \_\_\_\_\_  
 (HP) (yield gpm)  
 \_\_\_\_\_  
 (type power)
- (7) electric log \_\_\_\_\_  
 (yes or no)  
 \_\_\_\_\_  
 (organization running log)
- (8) how well bottom plugged good

description of formations encountered	from	to
Red Clay	1	10
purple clay	10	35
white sand	35	65
lags	65	74
Blue clay	74	232
very fine sandy	232	270
hard Blue Clay	270	392
fine sand	392	399
very coarse sand	399	420


**CODED**

0161958

DRILLERS REMARKS:

If well telescopes please sketch and show depths.

GROUND LEVEL.

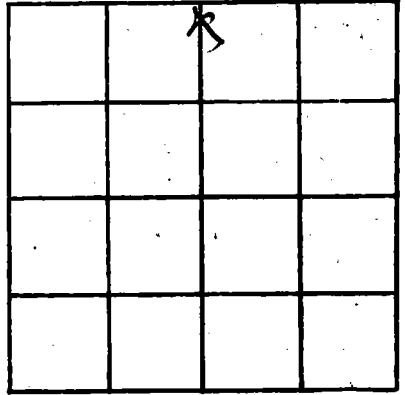

SECTION 33

Please indicate well location X.

ADDITIONAL INFORMATION

A series of horizontal lines for entering additional information, located below the 'ADDITIONAL INFORMATION' header.

If more than one screen, show locations of each on sketch.