

Harrison  
G 131  
9-15-69

MISSISSIPPI  
 BOARD OF WATER COMMISSIONERS  
 416 North State Street  
 Jackson, Mississippi 39201

CODED

WATER WELL DRILLERS LOG

9-15 1969 R. J. Moore HARRISON  
 date well completed firm name county well located

LANDOWNER: Charles BALLAUB  
RT #3 River RD  
Gulfport, Miss  
 (mailing address)

description of formations encountered	from	to
SURFACE SALT	0	20
COARSE SAND + GRAVEL	20	50
CLAY BALLS	50	80
FINE SAND	80	110
BLUE CLAY	110	240
BLUE SAND	240	284

WELL LOCATION:  
 sec. 25 T. 6 N. R. 11 E  
1 miles WEST of WALMART  
 (distance) (direction) (nearest town)

WELL PURPOSE: Home  
 (home, irrigation, municipal, industrial)

WELL COMPLETION DATA:

(1) diameter (inches) 2"

(2) total depth (feet) 284

(3) static water level (feet) 6' below above top of ground.

(4) casing galv 274'  
 (material) (depth)  
2" if telescope see back.  
 (size)

(5) screen 2x10 274'  
 (length) (depth to top)  
2" SS  
 (size) (material)

(6) pump \_\_\_\_\_ (HP) \_\_\_\_\_ (yield gpm)  
 (type power)

(7) electric log \_\_\_\_\_ (yes or no)  
 (organization running log)


(8) how well bottom plugged B.W.  
shale

DRILLERS REMARKS: 12 lb  
pressure

SEP 29 1969  
 MISS. Bd OF  
 WATER COM.

If well telescopes please sketch and show depths.

GROUND LEVEL

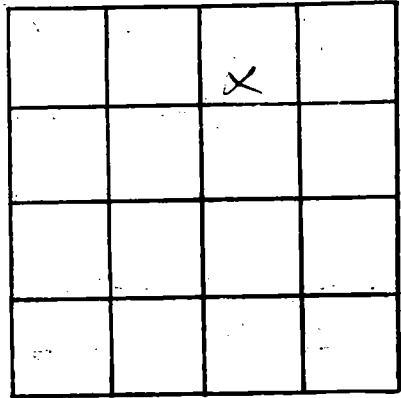

SECTION 25

Please indicate well location X.

ADDITIONAL INFORMATION

If more than one screen, show locations of each on sketch.