

Harrison
 G136
 12-16-69

MISSISSIPPI
 BOARD OF WATER COMMISSIONERS
 416 North State Street
 Jackson, Mississippi 39201

CODED
 CODED

WATER WELL DRILLERS LOG

Dec. 16-69 19 M & B Drilling Co. Harrison
 date well completed firm name county well located

LANDOWNER: Bilchrist Tractor
Highway 49 - Lyman, Miss
 (mailing address)

WELL LOCATION:
 sec. 28 T. 6 N R. 11 W
1/2 miles S of Lyman
 (distance) (direction) (nearest town)

WELL PURPOSE: Industrial
 (home, irrigation, municipal, industrial)

WELL COMPLETION DATA:
 (1) diameter (inches) 8x6x4
 (2) total depth (feet) 530
 (3) static water level (feet) 45 below top of ground.
 (4) casing Steel Total (material) (depth) 530
8x6x4 (size) if telescope see back.
 (5) screen 60 (length) (depth, to top) 40
40 (size) 5x Steel (material)
 (6) pump 30 (HP) 400 (yield gpm)
440 V 3P (type power)
 (7) electric log No (yes or no)
 (organization running log)
 (8) how well bottom plugged 4" Back Wash Valve

description of formations encountered	from	to
Sand Clay	0	10
White Clay	10	25
Gray Clay	25	45
Sand	45	60
Blue Clay	60	70
Sand & Clay Breeds	70	95
Black Clay	95	125
Sand & Clay Breeds	125	155
Dark Gray Clay	155	185
Blue Clay	185	243
Sand	243	244
Blue Clay	244	255
Sand	255	257
Blue Clay	257	305
Sand	305	325
Blue Clay	325	370
Sand	370	410
Blue Clay	410	425
Sand	425	525
Blue Clay	525	530+


DEC 25 1969

MISS. BD. OF
 WATER COMM

DRILLERS REMARKS:

If well telescopes please sketch and show depths.

GROUND LEVEL

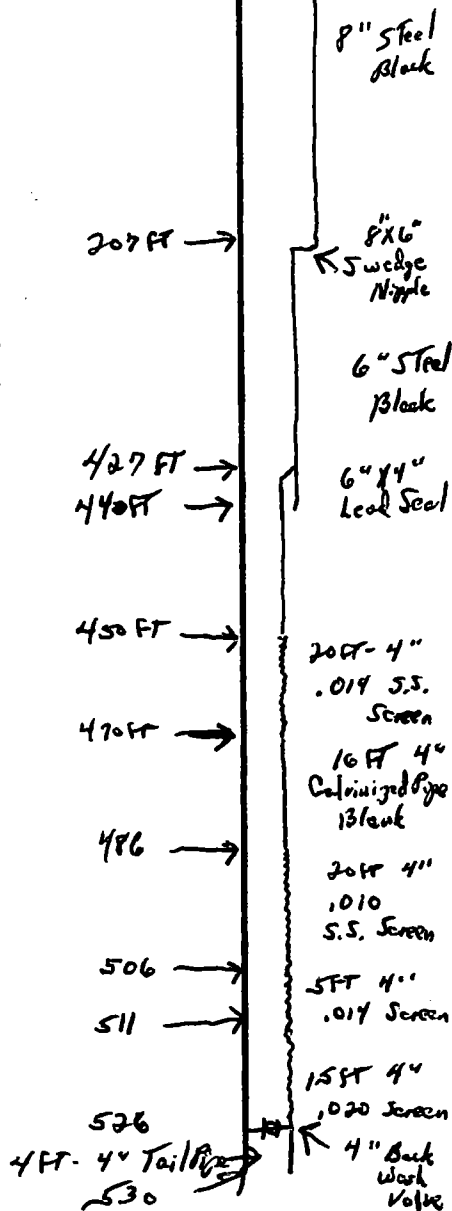

X			

SECTION 28

Please indicate well location X.

ADDITIONAL INFORMATION

Sand Analysis Retinence					
450-462		465-472			
.025	5%	.025	4%		
.020	8%	.020	6%		
.016	18%	.016	10%		
.014	34%	.014	20%		
.012	15%	.012	15%		
472-480		480-489		489-495	
.020	19%	.016	29%	.020	19%
.016	59%	.014	59%	.016	29%
.014	11%	.012	10%	.014	16%
.012	15%	.010	23%	.012	26%
.010	31%	.008	19%	.010	27%
495-502		502-510		510-517	
.020	19%	.025	20%	.025	25%
.016	29%	.020	25%	.020	33%
.014	8%	.016	20%	.016	22%
.012	24%	.014	18%	.014	13%
.010	37%				
517-525					
		.025		26%	
		.020		32%	
		.016		25%	
		.014		26%	

If more than one screen, show locations of each on sketch.