

HARRISON
G 142
12-24-69

MISSISSIPPI
BOARD OF WATER COMMISSIONERS
416 North State Street
Jackson, Mississippi 39201

CODED

WATER WELL DRILLERS LOG

12/24 1969 Postal Drill Harris
date well completed firm name county well located

LANDOWNER: Shorty Lorton
Rt 1 Box 700
Gulfport, Miss
(mailing address)

WELL LOCATION:
sec. 35 T. 6 N. R. 11 E.
(3) Three miles W of Woolmole
(distance) (direction) (nearest town)

WELL PURPOSE: Drinking
(home, irrigation, municipal, industrial)

WELL COMPLETION DATA:
(1) diameter (inches) 2"
(2) total depth (feet) 905
(3) static water level (feet) 11 below above top of ground
(4) casing glau 885
(material) (depth)
(size) if telescope see back.
(5) screen 20' 885
(length) (depth to top)
2" SS
(size) (material)
(6) pump 1HP 21
(HP) (yield gpm)
Ele
(type power)
(7) electric log no
(yes or no)

(organization running log)

description of formations encountered	from	to
Top Soil	1	5
White Sand	5	15
White Clay	15	30
glau	30	44
Sand	44	70
Blue Clay	70	340
Rock	340	342
fine water sand	342	367
hard Blue Clay	367	660
fine water sand	660	674
hard Blue Clay	674	780
fine water sand	780	798
Blue Clay	798	880
fine water sand	880	884
Coarse water sand	884	905

(8) how well bottom plugged
2' bottom water valve


DRILLERS REMARKS:
None

FEB 5 - 1970

MISS. DIV. OF
WATER CONTROL

If well telescopes please sketch and show depths.

GROUND LEVEL

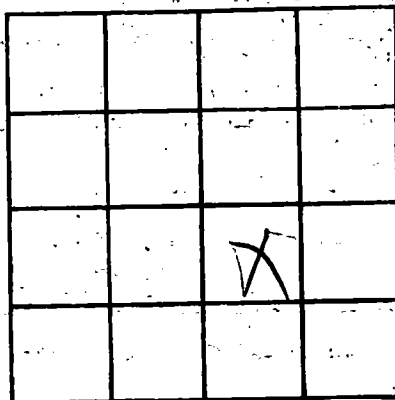

SECTION _____

Please indicate well location X.

ADDITIONAL INFORMATION

If more than one screen, show locations of each on sketch.