

HARRISON  
G143  
1-17-70

MISSISSIPPI  
BOARD OF WATER COMMISSIONERS  
416 North State Street  
Jackson, Mississippi 39201



WATER WELL DRILLERS LOG

1/17 1970 R.J. Moore HARRISON  
date well completed firm name county well located

LANDOWNER: Delta France  
Rt 2 Box 34  
Duepart miss  
(mailing address)

description of formations encountered	depth	
	from	to
TOP SOIL	0	24
White clay	24	50
White SAND	50	85
Blue clay	55	110
gray SAND	110	124

WELL LOCATION:  
sec. 29 T. 6 N. R. 11 E.  
OLD NY 49 IN LYMAN  
(distance) miles (direction) of (nearest town)

WELL PURPOSE: Home  
(home, irrigation, municipal, industrial)


- WELL COMPLETION DATA:
- diameter (inches) 2"
  - total depth (feet) 224'
  - static water level (feet) 24' <sup>below</sup> <sub>above</sub> top of ground.
  - casing galv, 210  
(material), (depth)  
(size) If telescope see back.
  - screen 10', 210  
(length) (depth to top)  
2", 55  
(size) (material)
  - pump \_\_\_\_\_  
(HP) (yield gpm)  
(type power)
  - electric log \_\_\_\_\_  
(yes or no)  
(organization running log)
  - how well bottom plugged BA  
1/2

DRILLERS REMARKS:

Feb.  
3 - 1970  
MISS. Bd. OF  
WATER COMM.

If well telescopes please sketch and show depths.

GROUND LEVEL

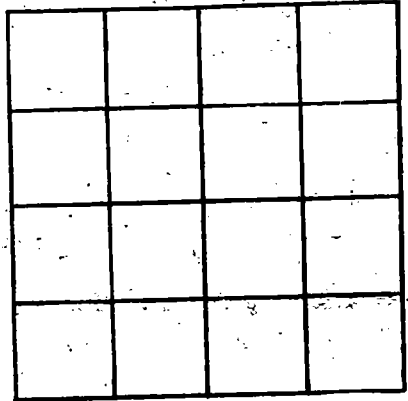

SECTION \_\_\_\_\_

Please indicate well location X.

ADDITIONAL INFORMATION

A series of horizontal lines for entering additional information.

If more than one screen, show locations of each on sketch.