

**MISSISSIPPI
BOARD OF WATER COMMISSIONERS**
416 North State Street
Jackson, Mississippi 39201

CODED

WATER WELL DRILLERS LOG

HARRISON
G 149
9-2-70

9/2 date well completed 20 Coastal Drilling Co. firm name Harrison county well located

LANDOWNER: Col. Deak
Rt 3 P.O. 600
Yellout Min
(mailing address)

WELL LOCATION:
sec 34 T 6 N R 11 E
3 miles W Woodmarket
(distance) (direction) (nearest town)

WELL PURPOSE: home
(home, irrigation, municipal, industrial)

- WELL COMPLETION DATA:
- (1) diameter (inches) 2"
 - (2) total depth (feet) 340
 - (3) static water level (feet) 31 below above top of ground.
 - (4) casing galv. 330
(material) (depth)
 - If telescope see back.
(size)
 - (5) screen 10' 330
(length) (depth to top)
 - 2" S.S.
(size) (material)
 - (6) pump 1 HP 17
(HP) (yield gpm)
 - Elc
(type power)
 - (7) electric log no
(yes or no)
 - (organization running log)

| description of formations encountered | from | to |
|---------------------------------------|------------|------------|
| <u>top soil</u> | <u>1</u> | <u>4</u> |
| <u>white sand</u> | <u>4</u> | <u>34</u> |
| <u>hard blue clay</u> | <u>34</u> | <u>249</u> |
| <u>fine white sand</u> | <u>249</u> | <u>266</u> |
| <u>hard blue clay</u> | <u>266</u> | <u>304</u> |
| <u>fine white sand</u> | <u>304</u> | <u>315</u> |
| <u>fine white sand</u> | <u>315</u> | <u>340</u> |

CODED


(8) how well bottom plugged 2 inch steel pipe
DRILLERS REMARKS: None

SEP 30 1970

MISS. BU. OF
WATER COMM.

If well telescopes please sketch and show depths.

GROUND LEVEL

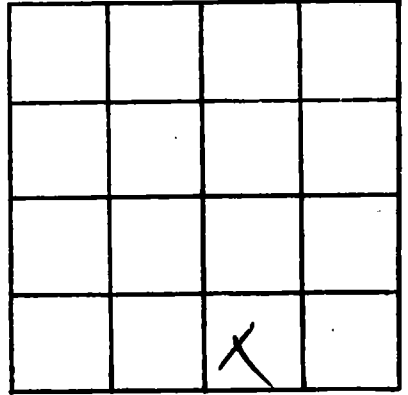

SECTION _____

Please indicate well location X.

ADDITIONAL INFORMATION

If more than one screen, show locations of each on sketch.