

HARRISON  
G 151  
8-25-70

MISSISSIPPI  
 BOARD OF WATER COMMISSIONERS  
 416 North State Street  
 Jackson, Mississippi 39201

**CODED**

WATER WELL DRILLERS LOG

8-25-70 19  
 date well completed

P. T. Moore  
 firm name

HARRISON  
 county well located

LANDOWNER:	description of formations encountered	from	to
<u>B.W. MARTIN</u> <u>SOUTH SWAN RD</u> <u>LYMAN MISS</u> (mailing address)			
<b>WELL LOCATION:</b> sec. <u>22</u> T. <u>6</u> N. R. <u>11</u> E. <u>2</u> miles <u>EAST</u> of <u>LYMAN</u> (distance) (direction) (nearest town)	<u>Red sand</u>	<u>10</u>	<u>17</u>
<b>WELL PURPOSE:</b> (home, irrigation, municipal, industrial)	<u>White clay</u>	<u>17</u>	<u>80</u>
<b>WELL COMPLETION DATA:</b>	<u>Rusty sand</u>	<u>80</u>	<u>85</u>
(1) diameter (inches) <u>2"</u>	<u>Blue clay</u>	<u>85</u>	<u>260</u>
(2) total depth (feet) <u>431'</u>	<u>FINE BLUE SAND</u>	<u>200</u>	<u>212</u>
(3) static water level (feet) <u>40'</u> <sup>below</sup> above top of ground.	<u>Blue clay</u>	<u>212</u>	<u>400</u>
(4) casing <u>9ALU</u> (material), <u>420'</u> (depth)	<u>Grey sand</u>	<u>400</u>	<u>431</u>
(size) If telescope see back.			
(5) screen <u>2x10</u> (length), <u>420'</u> (depth to top)			
<u>2"</u> (size), <u>SS</u> (material)			
(6) pump <u>1</u> (HP), <u>480 HR</u> (yield gpm)			
<u>800</u> (type power)			
(7) electric log _____ (yes or no)			
(organization running log)			
(8) how well bottom plugged <u>BW</u>			
<u>VALVE</u>			
<b>DRILLERS REMARKS:</b>			


**CODED**

AUG 28 1970

MISS. BOARD OF WATER COMMISSIONERS

If well telescopes please sketch and show depths.

GROUND LEVEL

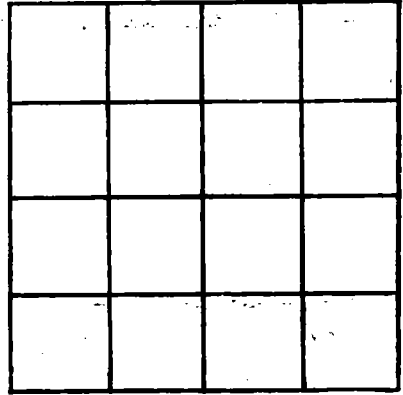

SECTION \_\_\_\_\_

Please indicate well location X.

ADDITIONAL INFORMATION

If more than one screen, show locations of each on sketch.