

HARRISON

G 153

10-24-70

MISSISSIPPI
 BOARD OF WATER COMMISSIONERS
 416 North State Street
 Jackson, Mississippi 39201

CODED

WATER WELL DRILLERS LOG

10/24/70
date well completed

Coastal Drilling Co.
firm name

Flomina
county well located

LANDOWNER: Hyge Holshel

description of formations encountered

from

to

Rt 3 Box 34

top soil

1

2

Gulfport Miss
(mailing address)

pink clay

3

14

white sand

14

49

Blue clay

49

144

fine water sand

144

152

Coarse water sand

152

172

WELL LOCATION:

sec 34 T 6 N R 11 E
S W
2 1/2 miles W London
(distance) (direction) (nearest town)

WELL PURPOSE: home
(home, irrigation, municipal, industrial)

WELL COMPLETION DATA:

- (1) diameter (inches) 2"
- (2) total depth (feet) 172
- (3) static water level (feet) 60 below top of ground.
- (4) casing Galv, 162
(material) (depth)
(size) If telescope see back.
- (5) screen 10', 162
(length) (depth to top)
2", SS
(size) (material)
- (6) pump 1 HP, 12
(HP) (yield gpm)
Ele
(type power)
- (7) electric log No
(yes or no)
No
(organization running log)
- (8) how well bottom plugged 2" backwash valve

CODED

DRILLERS REMARKS:


none

NOV 7 1970

MISS. BD. OF
WATER COMMISSIONERS

If well telescopes please sketch and show depths.

GROUND LEVEL

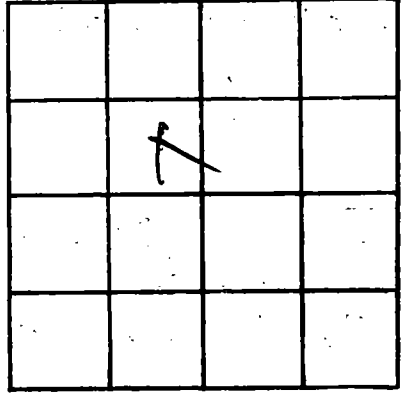

SECTION _____

Please indicate well location X.

ADDITIONAL INFORMATION

If more than one screen, show locations of each on sketch.