

HARRISON
G 155
12-4-70

MISSISSIPPI
 BOARD OF WATER COMMISSIONERS
 416 North State Street
 Jackson, Mississippi 39201

WATER WELL DRILLERS LOG

CODED

12-4-70 19 REV Moore HARRISON
 date well completed firm name county well located

LANDOWNER: Thomas Bryant
Box 300
Lyman Miss
 (mailing address)

WELL LOCATION:
 sec 30 T 6 N R 11 E
1 miles W of Lyman
 (distance) (direction) (nearest town)

WELL PURPOSE:
 (home, irrigation, municipal, industrial)

WELL COMPLETION DATA:

(1) diameter (inches) 2"

(2) total depth (feet) 480'

(3) static water level (feet) 45' ^{below} above top of ground.

(4) casing PVC 470'
 (material) (depth)
 (size) If telescope see back.

(5) screen 2x10 470'
 (length) (depth to top)
2" SS
 (size) (material)

(6) pump 1 6
 (HP) (yield gpm)
F
 (type power)

(7) electric log
 (yes or no)

 (organization running log)

(8) how well bottom plugged Yes

description of formations encountered	from	to
TOP SOIL	0	10
White Sand Clay	10	40
Blue Clay	40	150
SILTSTONE Blue	150	165
Blue Clay	165	440
Blue Sand	440	480

CODED


DEC 15 1970

MISS. BU. OF
 WATER COMM.

DRILLERS REMARKS:

If well telescopes please sketch and show depths.

GROUND LEVEL

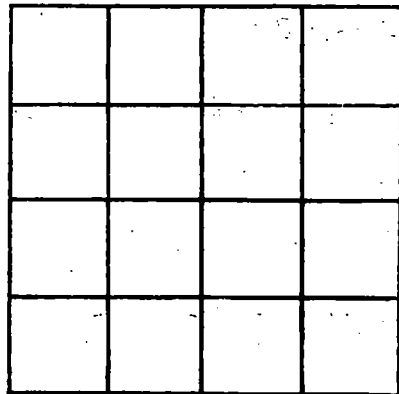

SECTION _____

Please indicate well location X.

ADDITIONAL INFORMATION

If more than one screen,
show locations of each on sketch.