

HARRISON

G 160

2-5-71

MISSISSIPPI BOARD OF WATER COMMISSIONERS  
416 North State Street  
Jackson, Mississippi 39201

**CODED**

WATER WELL DRILLERS LOG

Feb. 5 1971 Ladner's Well Works Harrison  
date well completed firm name county well located

LANDOWNER	description of formations encountered	from	to
Howard Doonin Robertson Road Gulfport, Miss. (mailing address)			
<b>WELL LOCATION:</b>			
sec. 31 T. 6 N. R. 11 E. S. W. 1 miles W of Dugout (distance) (direction) (nearest town)			
<b>WELL PURPOSE:</b> Home (home, irrigation, municipal, industrial)			
<b>WELL COMPLETION DATA:</b>			
(1) diameter (inches) 2 inch			
(2) total depth (feet) 505 feet			
(3) static water level (feet) 40 below top of ground			
(4) casing Galv. 495 ft. (material) (depth) 2 inch (size) if telescope see back.			
(5) screen 10 ft. 495 ft. (length) (depth to top) 2 inch (size) 55 (material)			
(6) pump 1 (HP) 8 gal (yield gpm) Elec. (type power)			
(7) electric log no (yes or no)			
(organization running log)			
(8) how well bottom plugged Ball Check			
<b>DRILLERS REMARKS:</b>			


**CODED**

1971

MISS. Bd. of  
WATER COMMISSIONERS

If well telescopes please sketch and show depths.

GROUND LEVEL

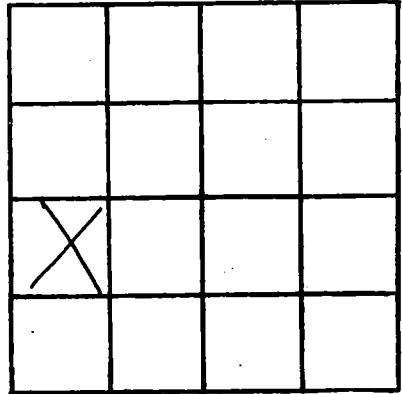

SECTION 31

Please indicate well location X.

ADDITIONAL INFORMATION

If more than one screen, show locations of each on sketch.