

HARRISON  
G-161  
8-24-71

MISSISSIPPI  
 BOARD OF WATER COMMISSIONERS  
 416 North State Street  
 Jackson, Mississippi 39201

**CODED**

WATER WELL DRILLERS LOG

Aug 24 19 71 M&B Drilling Co. Harrison  
 date well completed firm name county well located

LANDOWNER:  
Walter Daniels  
RN Saucier Miss  
 (mailing address)

description of formations encountered	from	to
<u>Yellow &amp; Red Clay</u>	<u>0</u>	<u>18</u>
<u>Sand &amp; Clay Brecker</u>	<u>18</u>	<u>60</u>
<u>Sand</u>	<u>60</u>	<u>80</u>
<u>Blue Clay</u>	<u>80</u>	<u>116</u>
<u>Grey Sand</u>	<u>116</u>	<u>136</u>
<u>Blue Clay</u>	<u>136</u>	<u>140</u>

WELL LOCATION:  
 sec. 8 T. 6 R. 11  
2 1/2 miles N of Hyman  
 (distance) (direction) (nearest town)

WELL PURPOSE: None  
 (home, irrigation, municipal, industrial)

WELL COMPLETION DATA:

(1) diameter (inches) 2"

(2) total depth (feet) 140

(3) static water level (feet) 20 below top of ground.

(4) casing PVC Total  
 (material) (depth)  
2" if telescope see back.  
 (size)

(5) screen 10ft 136  
 (length) (depth to top)  
2" PVC .010  
 (size) (material)

(6) pump 1/2 10  
 (HP) (yield gpm)  
220V 1P  
 (type power)

(7) electric log No  
 (yes or no)

(organization running log)

**CODED**

SEP 1 1971

MISS. BD. OF  
 WATER COMM.


(8) how well bottom plugged  
2" PVC Cap

DRILLERS REMARKS:

If well telescopes please sketch and show depths.

CODED

GROUND LEVEL

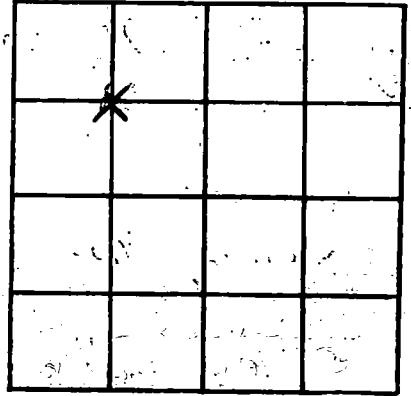

SECTION 8

Please indicate well location X.

ADDITIONAL INFORMATION

CODED

If more than one screen, show locations of each on sketch.