

HARRISON
G-162
8-10-71

MISSISSIPPI
 BOARD OF WATER COMMISSIONERS
 416 North State Street
 Jackson, Mississippi 39201

WATER WELL DRILLERS LOG

CODED

Aug. 10 1971 McNeil Well Works Harrison
 date well completed firm name county well located

LANDOWNER: Kennedy Cook
R. 23 Everbree, Inadocud
Belopi, Miss.
 (mailing address)

WELL LOCATION:
 sec. 19 T. 6 N. R. 11 E
4 miles NE of Lyman
 (distance) (direction) (nearest town)

WELL PURPOSE: none
 (home, irrigation, municipal, industrial)

WELL COMPLETION DATA:

- (1) diameter (inches) 2"
- (2) total depth (feet) 419'
- (3) static water level (feet) 98 below above top of ground.
- (4) casing galvanized 409'
 (material) (depth)
- No if telescope see back.
 (size)
- (5) screen 10' (length) (depth to top)
2" (size) 5.5. (material)
- (6) pump 1 (HP) 9 (yield gpm)
Electric (type power)
- (7) electric log No (yes or no)
No (organization running log)
- (8) how well bottom plugged Sand
Shank

description of formations encountered	from	to
top soil	0	5
Red clay	5	32
sand	35	86
Blue Mud	86	342
Slush	342	389
sand	389	419

CODED


SEP 13 1971

MISS. BD. OF
 WATER COMMISSIONERS

DRILLERS REMARKS:

If well telescopes please sketch and show depths.

GROUND LEVEL

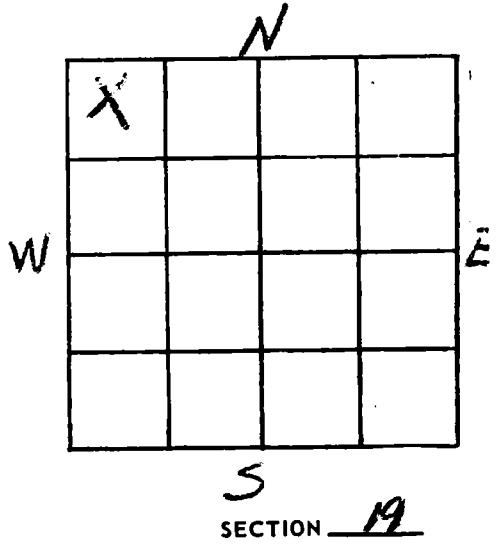

Please indicate well location X.

ADDITIONAL INFORMATION

If more than one screen, show locations of each on sketch.