

G 163
10-20-60

WATER WELL DRILLERS LOG

Date: 10-20, 1960, Driller: J. D. Bell

CODED

(1) Owner of Land: Jimmie Waller
(Name)
Rt 1 Dan Christman
(Address)
29 1/2 7th Highway
(2) Location: 1/4, 1/4, 29 1/2 7th Highway
Sec. 1 miles WEST of Dadeville
(distance) (direction) (Nearest Town)
(3) Topography: (Hilly) (Flat) (Level)
(4) Purpose of Well: Home use
(Domestic Irrigation
Municipal, Industrial, Other)


Description & Color of Materials Sand, Clay, Red Clay, Shell, etc.	Thick- ness Feet	Depth Feet
<u>first 30ft Red Sand & Clay</u>		<u>30</u>
<u>next 200ft strata fine sand</u>	<u>2</u>	<u>30</u>
<u>Hard Blue Clay</u>		<u>59</u>
<u>strata for water</u>		<u>40</u>
<u>Total Dept</u>	<u>3</u>	<u>59</u>

Information upon completion of well:

(1) Diameter 2 1/4 inches.
(2) Total Depth 359 feet.
(3) Water Level 40 ft feet below top of ground.
(4) Cased to _____, Size _____
(5) Screen: Size 1 1/4" , Length 14 ft.
(6) Were any formations sealed against pollution?
_____ yes, _____ no.

CODED

If YES depth of formation _____
Why _____
Drillers Remarks: _____

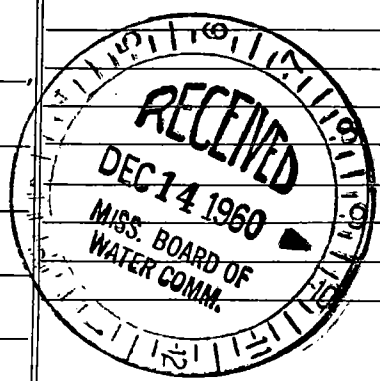

(Use Back Side)

Well No.

1950

DATE	DESCRIPTION	AMOUNT
1/1		
1/2		
1/3		
1/31		

000000