

HARRISON

G 168

11-22-71

MISSISSIPPI  
 BOARD OF WATER COMMISSIONERS  
 416 North State Street  
 Jackson, Mississippi 39201

WATER WELL DRILLERS LOG

Nov 22 1971 date well completed      Coastal Drilling Co. firm name      Harrison county well located


LANDOWNER	description of formations encountered	from	to
<u>Emmal Clark</u> <u>Rt 2 Box 473</u>	<u>Top Soil</u>	<u>1</u>	<u>3</u>
<u>Shelton, Doris</u> (mailing address)	<u>Red Clay</u>	<u>3</u>	<u>16</u>
WELL LOCATION:	<u>White Sand</u>	<u>76</u>	<u>20</u>
sec <u>31</u> T <u>6</u> N R. <u>11</u> E S W W <u>(2) 1/2</u> miles <u>SW</u> of <u>Lynum</u> (distance) (direction) (nearest town)	<u>hard Blue Clay</u>	<u>20</u>	<u>340</u>
WELL PURPOSE: <u>Home</u> (home, irrigation, municipal, industrial)	<u>fine water sand</u>	<u>340</u>	<u>370</u>
WELL COMPLETION DATA:	<u>Blue Clay</u>	<u>350</u>	<u>375</u>
(1) diameter (inches) <u>2"</u>	<u>fine water sand</u>	<u>375</u>	<u>400</u>
(2) total depth (feet) <u>440</u>	<u>Blue Clay</u>	<u>400</u>	<u>410</u>
(3) static water level (feet) <u>56</u> below top of ground	<u>Coarse water sand</u>	<u>410</u>	<u>440</u>
(4) casing <u>galv</u> <u>430</u> (material) (depth)			
(size) If telescope see back.			
(5) screen <u>10'</u> <u>430</u> (length) (depth to top)			
(size) <u>2"</u> (material) <u>S.S.</u>			
(6) pump <u>one</u> <u>15</u> (HP) (yield gpm)			
(type power) <u>Ele</u>			
(7) electric log <u>No</u> (yes or no)			
(organization running log)			
(8) how well bottom plugged <u>2" back wash valve</u>			
DRILLERS REMARKS: <u>None</u>			

JAN 10 1972

MISS. BD. OF WATER COM.

If well telescopes please sketch and show depths.

GROUND LEVEL

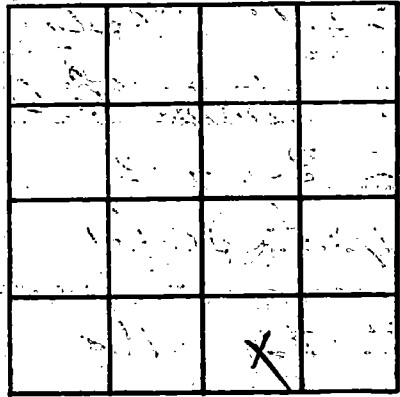

SECTION \_\_\_\_\_

Please indicate well location X.

ADDITIONAL INFORMATION

If more than one screen,  
show locations of each on sketch.