

HARRISON

G170

9-8-71

MISSISSIPPI BOARD OF WATER COMMISSIONERS  
416 North State Street  
Jackson, Mississippi 39201

FEB 14 1972

WATER WELL DRILLERS LOG

MISS. BD. OF WATER

Sept. 8, 71 19  
date well completed

m c jill well works  
firm name

Harrison  
county well located

LANDOWNER: T.S. Hoodby

42-30<sup>th</sup> St.

Bulfport, Miss.  
(mailing address)

WELL LOCATION:

sec. 32 T. 6 N. R. 11 E  
6 miles SW of Lumberton  
(distance) (direction) (nearest town)

WELL PURPOSE: Home  
(home, irrigation, municipal, industrial)

WELL COMPLETION DATA:

(1) diameter (inches) 2 1/8" x 2"

(2) total depth (feet)

(3) static water level (feet) 28' below top of ground

(4) casing gal. 208'  
(material) (depth)

(size) if telescope see back.

(5) screen 10'  
(length) (depth to top)

2" S.S.  
(size) (material)

(6) pump 1 HP 7 (yield gpm)

electric  
(type power)

(7) electric log NO  
(yes or no)

(organization running log)

(8) how well bottom plugged sand  
shark


description of formations encountered	from	to
topsoil	0	5
clay	5	22
sand	22	68
blue clay	68	185
sand	185	218

CODED

DRILLERS REMARKS:

If well telescopes please sketch and show depths.

GROUND LEVEL

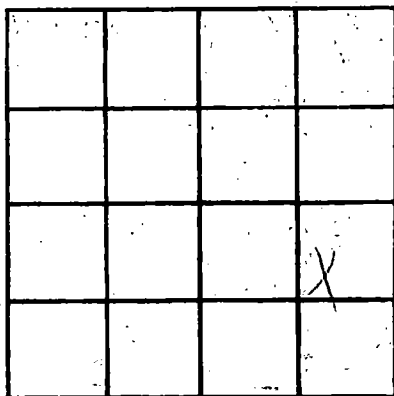

SECTION 32

Please indicate well location X.

ADDITIONAL INFORMATION

If more than one screen, show locations of each on sketch.