

HARRISON
G172
2-9-72

MISSISSIPPI
 BOARD OF WATER COMMISSIONERS
 416 North State Street
 Jackson, Mississippi 39201

CODED

WATER WELL DRILLERS LOG

Feb 9 1972 firm with water wk Harrison
 date well completed firm name county well located

LANDOWNER: Raymond Walker
Sydney Miss.
 (mailing address)

WELL LOCATION:
 sec. 20 T. 6 R. 11
1/2 miles 40 of Sydney
 (distance) (direction) (nearest town)

WELL PURPOSE: Home
 (home, irrigation, municipal, industrial)

WELL COMPLETION DATA:

- (1) diameter (inches) 2"
- (2) total depth (feet) 452
- (3) static water level (feet) 28 ~~above~~ below top of ground.
- (4) casing gal pipe, 452,
 (material) (depth)
2"
 (size) if telescope see back.
- (5) screen 10, 442
 (length) (depth to top)
2, Side on gal pipe
 (size) (material)
- (6) pump 1 10
 (HP) (yield gpm)
Elec
 (type power)
- (7) electric log NR
 (yes or no)
NR
 (organization/running log)
- (8) how well bottom plugged Sand
Shank



description of formations encountered	from	to
<u>white clay</u>	<u>0</u>	<u>160</u>
<u>fine sand</u>	<u>160</u>	<u>180</u>
<u>Blue pgl clay</u>	<u>180</u>	<u>410</u>
<u>sand water 10' at</u>	<u>410</u>	<u>452</u>
CODED		
MAY 25 1972		
MISS. BD. OF WATER COMMISSIONERS		

DRILLERS REMARKS:

If well telescopes please sketch and show depths.

1000

GROUND LEVEL

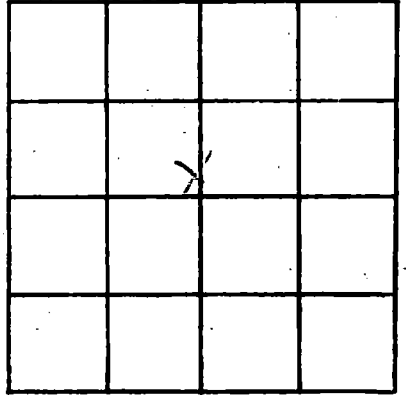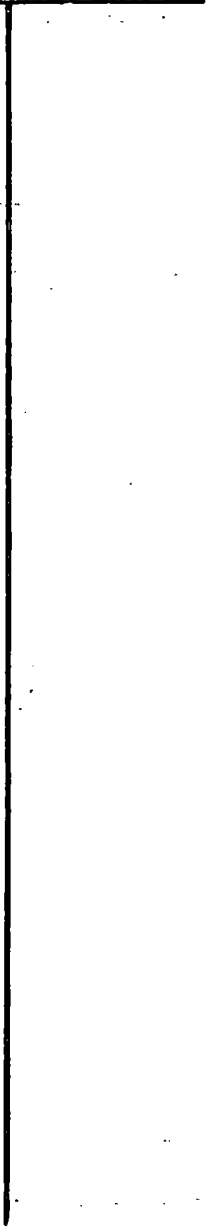

SECTION _____

Please indicate well location X.

ADDITIONAL INFORMATION

Lined area for additional information.

If more than one screen, show locations of each on sketch.