




If well telescopes please sketch and show depths.



GROUND LEVEL

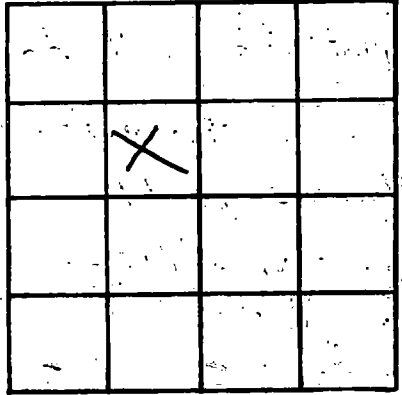

SECTION 2

Please indicate well location X.

ADDITIONAL INFORMATION

COPIED

If more than one screen, show locations of each on sketch.