

HARRISON  
G 183  
10-15-71

MISSISSIPPI  
BOARD OF WATER COMMISSIONERS  
416 North State Street  
Jackson, Mississippi 39201

WATER WELL DRILLERS LOG

Oct 15 1971 date well completed  
Peninsula Waterworks firm name  
Harrison county well located

LANDOWNER: J. J. J. J.  
Pillar River Estates  
Lumbert, Miss.  
(mailing address)

description of formations encountered	from	to
red clay	0	20
red sand + small gravel	20	35
white & blue pipe clay	35	230
hard shale	230	246

WELL LOCATION:  
sec. 35 T. 6 N. R. 11 E. S. W.  
0 miles (distance) 3 miles (direction) of Coahoma (nearest town)

WELL PURPOSE: Home  
(home, irrigation, municipal, industrial)

- WELL COMPLETION DATA:
- (1) diameter (inches) 2"
  - (2) total depth (feet) 2'
  - (3) static water level (feet) 55 below top of ground
  - (4) casing pvc, 236 (material), (depth)
  - 2" (size) if telescope see back.
  - (5) screen 10, 246 (length), (depth to top)
  - 2" pvc (size), (material)
  - (6) pump ~~#~~ (HP), (yield gpm)
  - Elec. (type power)
  - (7) electric log (yes or no)


both given to J. J. J. J.  
Aug 3-1971

(organization running log)  
(8) how well bottom plugged sand  
shards

DRILLERS REMARKS:

If well telescopes please sketch and show depths.

GROUND LEVEL

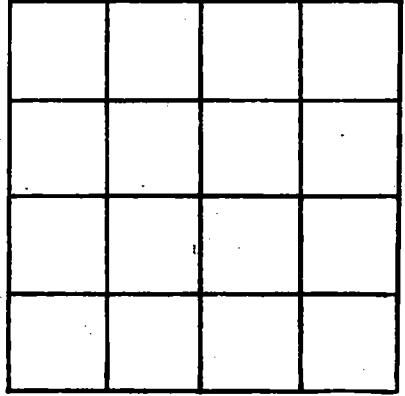

SECTION \_\_\_\_\_

Please indicate well location X.

ADDITIONAL INFORMATION

If more than one screen, show locations of each on sketch.