

HARRISON  
G 185  
10-10-72

MISSISSIPPI  
 BOARD OF WATER COMMISSIONERS  
 416 North State Street  
 Jackson, Mississippi 39201  
 WATER WELL DRILLERS LOG

OCT 10-72 19  
 date well completed

**CODED**

MOORE  
 firm name

HARRISON  
 county well located

LANDOWNER: A. HOLLAND  
RTE 2 LIZIAMA RD  
Shocket, MISS  
 (mailing address)  
 WELL LOCATION:  
 sec. 2 T. 6 N. R. 11 E  
3/4 miles NE of LIZIAMA  
 (distance) (direction) (nearest town)

description of formations encountered	from	to
<u>DP Soil</u>	<u>10</u>	<u>10</u>
<u>red &amp; white clay</u>	<u>10</u>	<u>118</u>
<u>white clay</u>	<u>110</u>	<u>140</u>
<u>rusty sand</u>	<u>140</u>	<u>170</u>
<u>blue clay</u>	<u>190</u>	<u>290</u>
<u>gray sand</u>	<u>290</u>	<u>325</u>

WELL PURPOSE:  
 (hole, irrigation, municipal, industrial)

WELL COMPLETION DATA:  
 (1) diameter (inches) 2"  
 (2) total depth (feet) 325'  
 (3) static water level (feet) 58' <sup>below</sup> above top of ground.  
 (4) casing PVC 315'  
 (material) (depth)  
 (size) if telescope see back.  
 (5) screen 10' 315'  
 (length) (depth to top)  
2" 95  
 (size) (material)  
 (6) pump 1 9  
 (HP) (yield gpm)  
6  
 (type power)  
 (7) electric log yes or no  
organization running log  
 (8) how well bottom plugged yes  
with

**CODED**


OCT 28 1972

DRILLERS REMARKS:

INCOME TAX  
 WATER

If well telescopes please sketch and show depths.

GROUND LEVEL

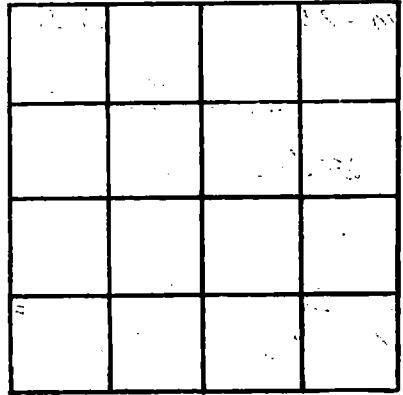

SECTION \_\_\_\_\_

Please indicate well location X.

**ADDITIONAL INFORMATION**

If more than one screen, show locations of each on sketch.