

HARRISON
G 187
10-11-72

MISSISSIPPI
 BOARD OF WATER COMMISSIONERS

416 North State Street
 Jackson, Mississippi 39201

WATER WELL DRILLERS LOG

10-11 1972 Switzer Well Co. Harrison
 date well completed firm name county well located

LANDOWNER: L.B. ANDERSON
Mock Road, Bicoxi River Est.
Bicoxi, Miss.
 (mailing address)

WELL LOCATION:
 sec 31 T 6 S R 11 W
4 miles NE of Gulfport
 (distance) (direction) (nearest town)

WELL PURPOSE: Home
 (home, irrigation, municipal, industrial)

WELL COMPLETION DATA:

(1) diameter (inches) 2"

(2) total depth (feet) 452'

(3) static water level (feet) 21' ^{below} above top of ground.

(4) casing galv. 452'
 (material) (depth)
 (size) If telescope see back.

(5) screen 10' 442'
 (length) (depth to top)
008 Stainless Steel
 (size) (material)

(6) pump 1/2 8.1
 (HP) (yield gpm)
Electric
 (type power)

(7) electric log no
 (yes or no)
 (organization running log)

(8) how well bottom plugged back
pressure Valve

description of formations encountered	from	to
Clay-sand mixed	0	23
sand	23	57
clay	57	194
clay-sand sh.	194	215
sand, fine	215	220
clay	220	256
sand, fine	256	276
clay	276	321
sand, fine	321	360
clay	360	407
sand, fine	407	428
sand, fine	428	452

COILED


NOV - 2 1972

MISS. BD. OF
 WATER COMMISSIONERS

DRILLERS REMARKS:

If well telescopes please sketch and show depths.

GROUND LEVEL

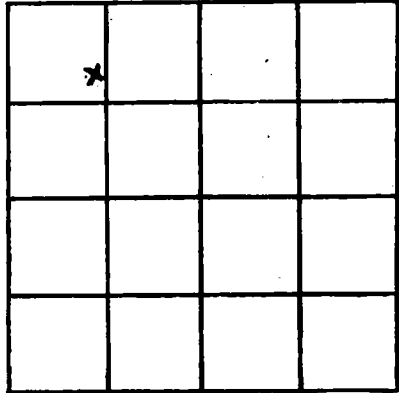

SECTION 31

Please indicate well location X.

ADDITIONAL INFORMATION

If more than one screen, show locations of each on sketch.