

HARRISON
G190
9-18-72

MISSISSIPPI
BOARD OF WATER COMMISSIONERS
416 North State Street
Jackson, Mississippi 39201

CODED

WATER WELL DRILLERS LOG

Sept. 18 1972 Mc Gil well works Harrison
date well completed firm name county well located

LANDOWNER: Darcy P. Curvas
Rt. 2, Box 254
Gulfport, Miss.
(mailing address)

description of formations encountered	from	to
loess	0	2
clay	2	86
fine sand	86	91
clay	91	142
fine sand	142	177
course sand	177	200

WELL LOCATION:
sec. 28 T. 6 N R. 11 E
S W
4 miles S of Lyman
(distance) (direction) (nearest town)

WELL PURPOSE: home
(home, irrigation, municipal, industrial)

- WELL COMPLETION DATA:
- (1) diameter (inches) 2"
 - (2) total depth (feet) 200 ft.
 - (3) static water level (feet) _____ below/above top of ground.
 - (4) casing gal. 190'
(material) (depth)
 - (size) If telescope see back.
 - (5) screen 10'
(length) (depth to top)
 - 2" plastic
(size) (material)
 - (6) pump 1 (HP) (yield gpm)
electric
(type power)
 - (7) electric log no
(yes or no)
 - (organization running log)
 - (8) how well bottom plugged sand
shark


CODED

DRILLERS REMARKS:

MISSISSIPPI BOARD OF WATER COMMISSIONERS

If well telescopes please sketch and show depths.

GROUND LEVEL

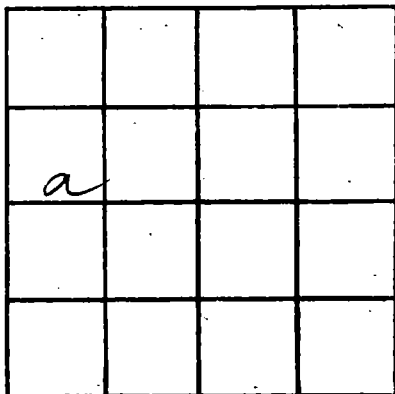

SECTION 28

Please indicate well location X.

ADDITIONAL INFORMATION

A series of horizontal lines for writing additional information.

If more than one screen, show locations of each on sketch.