

MISSISSIPPI
BOARD OF WATER COMMISSIONERS
416 North State Street
Jackson, Mississippi 39201

CODED

WATER WELL DRILLERS LOG

HARRISON
G192
1-18-73

1-18 1973 Switzer Well Co. HARRISON
date well completed firm name county well located

LANDOWNER: Zelda Swinton
Rt 3 Box 685
Georgetown, Miss. 39501
(mailing address)

WELL LOCATION:
sec. 31 T. 6 S. R. 11 W.
7 miles N of Georgetown
(distance) (direction) (nearest town)

WELL PURPOSE:
(home, irrigation, municipal, industrial)

WELL COMPLETION DATA:

- (1) diameter (inches) 2"
- (2) total depth (feet) 492'
- (3) static water level (feet) 27 ^{below}/_{above} top of ground.
- (4) casing galv. 492'
(material) (depth)
- (size) If telescope see back.
- (5) screen 10' 482'
(length) (depth to top)
- 008 stainless steel
(size) (material)
- (6) pump 1 10
(HP) (yield gpm)
- ELECTRIC
(type power)
- (7) electric log no
(yes or no)
- (organization running log)

(8) how well bottom plugged back
pressure valve

description of formations encountered	from	to
clay-sand mix	0	23
clay	23	66
sand	66	76
clay	76	108
clay-sand str.	108	129
clay	129	172
sand	172	178
clay	178	190
sand	190	219
clay	219	279
clay-sand str.	279	300
clay	300	464
sand	464	492


CODED

FEB 8 1973

DRILLERS REMARKS:

If well telescopes please sketch and show depths.

GROUND LEVEL

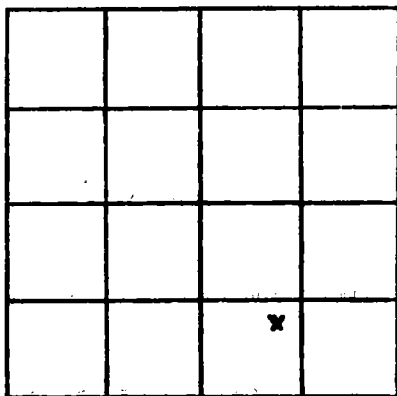

SECTION 31

Please indicate well location X.

ADDITIONAL INFORMATION

If more than one screen, show locations of each on sketch.