

HARRISON

G 193

2-26-73

MISSISSIPPI BOARD OF WATER COMMISSIONERS
416 North State Street
Jackson, Mississippi 39201

CODED

WATER WELL DRILLERS LOG

2-26-73

19

R. J. Moore

HARRISON

date well completed

firm name

county well located

LANDOWNER: Tom Fulis

Gen Del

LYMAN, MISS

(mailing address)

WELL LOCATION:

sec. 17 T. 6 N. R. 11 E

2 miles N of LYMAN
(distance) (direction) (nearest town)

WELL PURPOSE:

(home, irrigation, municipal, industrial)

WELL COMPLETION DATA:

- (1) diameter (inches) 2"
- (2) total depth (feet) 390'
- (3) static water level (feet) 1' ^{below} _{above} top of ground.
- (4) casing galv (material), 380 (depth),
(size) if telescope see back.
- (5) screen 10' (length), 380' (depth to top),
2" (size), SS (material)
- (6) pump (HP) (yield gpm)
(type power)
- (7) electric log (yes or no)
(organization running log)
- (8) how well bottom plugged 100%
white

description of formations encountered

from to

TOP SOIL	0	10
White Sand	10	50
Blue Clay	50	130
FINE SILT, Blue Sand	130	140
Blue Clay	140	280
Gravelly Sand FINE	280	340
Blue Clay	340	380
Coarse Gravel Sand	380	390


CODED

DRILLERS REMARKS:

2-26-73

If well telescopes please sketch and show depths.

GROUND LEVEL

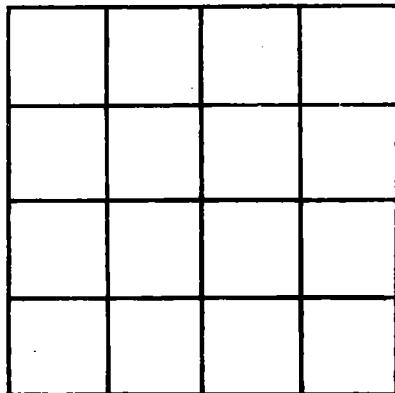

SECTION _____

Please indicate well location X.

ADDITIONAL INFORMATION

If more than one screen, show locations of each on sketch.