

HARRISON
G 200
5-30-73

MISSISSIPPI
 BOARD OF WATER COMMISSIONERS
 416 North State Street
 Jackson, Mississippi 39201

CODED

WATER WELL DRILLERS LOG

5/30 1973 MB Drilling Co. Inc. Harrison
 date well completed firm name county well located

LANDOWNER: William James

Pt. 1 Boop
Saucier, Miss.
 (mailing address)

WELL LOCATION:
 sec. 8 T. 6 N. R. 11 E
3 miles N of Lyman
 (distance) (direction) (nearest town)

WELL PURPOSE: Home
 (home, irrigation, municipal, industrial)

- WELL COMPLETION DATA:
- (1) diameter (inches) 2
 - (2) total depth (feet) 420
 - (3) static water level (feet) 600 below top of ground
 - (4) casing Galv. Steel, 410
 (material) (depth)
2"
 (size) if telescope see back.
 - (5) screen 10ft, 410
 (length) (depth to top)
2", Stainless Steel
 (size) (material)
 - (6) pump 1, 10
 (HP) (yield gpm)
220 V 1Ø
 (type power)
 - (7) electric log No
 (yes or no)

(organization running log)

(8) how well bottom plugged
2" Backwash Valve

description of formations encountered	from	to
Purple Clay	0	10
White Clay	10	30
Red Clay	30	105
Blue Clay	105	225
Sand	225	230
Blue Clay	230	380
Sand	380	430
Bottom	430	


CODED

JUN 15 1973

DRILLERS REMARKS:

If well telescopes please sketch and show depths.

GROUND LEVEL

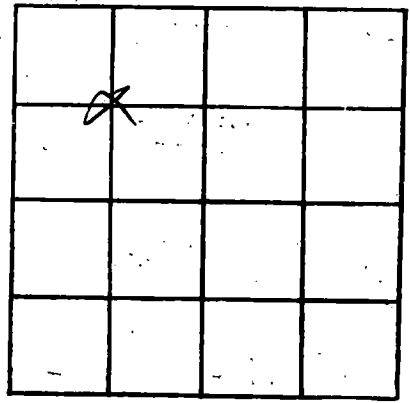

SECTION 8

Please indicate well location X.

ADDITIONAL INFORMATION

If more than one screen, show locations of each on sketch.