

HARRISON
G 201
12-6-72

MISSISSIPPI
BOARD OF WATER COMMISSIONERS
416 North State Street
Jackson, Mississippi 39201

CODED

WATER WELL DRILLERS LOG

DECEMBER 6, 1972 H.A. Ladnier's Well Works HARRISON
date well completed firm name county well located

LANDOWNER: MR. JAMES BARRETT

description of formations encountered

from

to

Rt. 7, Box 68
Gulfport, Miss.
(mailing address)

YELLOW CLAY	0	35
YELLOW SAND	35	55
BLUE CLAY	55	195
BLUE SAND	195	240

WELL LOCATION:

sec. 2 T. 6^N R. 11 E
S W
 1/2 miles west of SAUCIER
(distance) (direction) (nearest town)

WELL PURPOSE: HOME
(home, irrigation, municipal, industrial)

CODED

WELL COMPLETION DATA:

- (1) diameter (inches) 2 inch
 (2) total depth (feet) 240 FT.
 (3) static water level (feet) 40 FT below above top of ground.
 (4) casing Galv. 230 FT.
(material) (depth)
2 in. if telescope see back.
(size)
 (5) screen 10 FT. 230 FT.
(length) (depth to top)
2 in. S. STEEL
(size) (material)
 (6) pump 1 8
(HP) (yield gpm)
ELECT.
(type power)
 (7) electric log No
(yes or no)

(organization running log)


(8) how well bottom plugged Ball Check

DRILLERS REMARKS:

JUN 22 1972

If well telescopes please sketch and show depths.

GROUND LEVEL

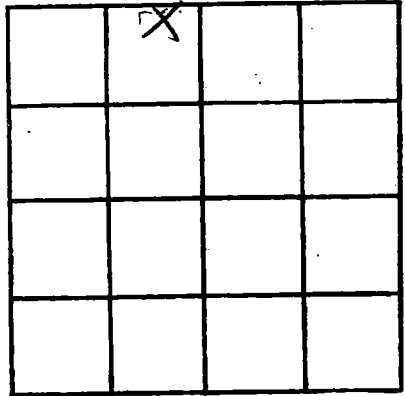

SECTION 2

Please indicate well location X.

ADDITIONAL INFORMATION

If more than one screen, show locations of each on sketch.