

HARRISON
G206
10-4-73

MISSISSIPPI
BOARD OF WATER COMMISSIONERS
416 North State Street
Jackson, Mississippi 39201

G206

CODED

WATER WELL DRILLERS LOG

10-4-73 19 R. J. Moore HARRISON
date well completed firm name county well located

LANDOWNER: RONNIE WEBBY
PT 3 JOHN CLARK RD
GULFPORT, MISS
(mailing address)

description of formations encountered	from	to
TOP SOIL	0	10
White Sand	10	40
White Clay	40	90
Blue Sand 3147	90	100
Blue Clay	100	500
Coarse Gravelly Sand	500	540

WELL LOCATION:
sec 30 T 6 N R 11 E
1 1/2 miles W of Natchez
(distance) (direction) (nearest town)

WELL PURPOSE:
(Home, Irrigation, municipal, industrial)

WELL COMPLETION DATA:

(1) diameter (inches) 2"

(2) total depth (feet) 540

(3) static water level (feet) 27' below above top of ground

(4) casing 9444 530'
(material) (depth)

(size) if telescope see back.

(5) screen 10' 530'
(length) (depth to top)

2" SS
(size) (material)

(6) pump 1/2 5
(HP) (yield gpm)

8
(type power)

(7) electric log (yes or no)

(organization running log)

(8) how well bottom plugged
by wire

CODED


DRILLERS REMARKS:

OCT 26 1973

MISS. BD. OF
WATER COM.

If well telescopes please sketch and show depths.

GROUND LEVEL

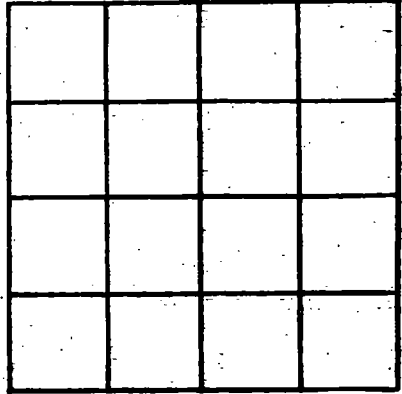

SECTION _____

Please indicate well location X.

ADDITIONAL INFORMATION

If more than one screen, show locations of each on sketch.