

HARRISON
G 207
10-6-73

MISSISSIPPI
BOARD OF WATER COMMISSIONERS
416 North State Street
Jackson, Mississippi 39201

G 207

WATER WELL DRILLERS LOG CODED

10-6-73 19 RJ Moore firm name HARRISON county well located


LANDOWNER: <u>W.C. Richmond</u>	description of formations encountered	from	to
<u>RT 3 JOHN Clarke RD</u>			
<u>GULSPORT, MISS</u> (mailing address)	<u>TOP SOIL</u>	<u>0</u>	<u>10</u>
	<u>white sand</u>	<u>10</u>	<u>20</u>
	<u>white clay</u>	<u>20</u>	<u>90</u>
	<u>FINE SAND</u>	<u>90</u>	<u>110</u>
	<u>Blue clay</u>	<u>110</u>	<u>490</u>
	<u>COARSE SAND</u>	<u>490</u>	<u>518</u>
WELL LOCATION: sec <u>32</u> T <u>6</u> N R <u>11</u> E <u>1 1/2</u> miles <u>W</u> of <u>MOBILE</u> (distance) (direction) (nearest town)			
WELL PURPOSE: (<input checked="" type="checkbox"/> Home, <input type="checkbox"/> Irrigation, <input type="checkbox"/> municipal, <input type="checkbox"/> Industrial)			
WELL COMPLETION DATA: (1) diameter (inches) <u>2"</u> (2) total depth (feet) <u>518</u> (3) static water level (feet) <u>22'</u> ^{below} _{above} top of ground. CODED (4) casing <u>944</u> <u>508'</u> (material) (depth) If telescope see back. (size) (5) screen <u>10'</u> <u>508</u> (length) (depth to top) <u>2"</u> (size) (material) (6) pump <u>1/2</u> <u>5</u> (HP) (yield gpm) <u>E</u> (type power) (7) electric log _____ (yes or no) (organization running log) (8) how well bottom plugged <u>By wire</u>			
DRILLERS REMARKS: _____			

OCT 26 1973

Miss. Bd. of
WATER COMMISSIONERS

If well telescopes please sketch and show depths.

GROUND LEVEL

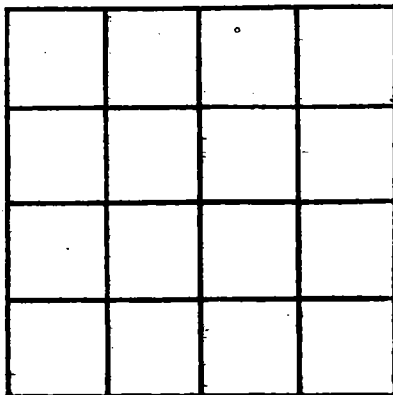

SECTION _____

Please indicate well location X.

ADDITIONAL INFORMATION

If more than one screen, show locations of each on sketch.