

HARRISON
G 208
11-20-73

MISSISSIPPI
BOARD OF WATER COMMISSIONERS
416 North State Street
Jackson, Mississippi 39201
WATER WELL DRILLERS LOG

CODED

11-20-73 19 R. J. Moore HARRISON
date well completed firm name county well located

LANDOWNER: E. M. Tootle
PT #3 South Swan RD
LYMAN, MISS
(mailing address)

description of formations encountered	from	to
TOP SOIL	0	10
Red Sand	10	40
Blue Clay	110	200
Thin Blue Sand	200	240
Blue Clay	240	440
Blue Sand med	440	448
Blue Clay	448	445
Grey Sand (med)	445	470
Grey Sand coarse	470	480

WELL LOCATION:
sec 22 T 6 N R 11 E
2 miles E of LYMAN
(distance) (direction) (nearest town)

WELL PURPOSE:
(home, irrigation, municipal, industrial)

WELL COMPLETION DATA:
(1) diameter (inches) 2"
(2) total depth (feet) 480'
(3) static water level (feet) 28' below above top of ground
(4) casing 9" galv 470'
(material) (depth)
(size) If telescope see back.
(5) screen 10' 470'
(length) (depth to top)
2' 55
(size) (material)
(6) pump 1 10
(HP) (yield gpm)
E
(type power)
(7) electric log (yes or no)
(organization running log)
(8) how well bottom plugged
Sewer line


CODED

DEC 10 1973

DRILLERS REMARKS:

If well telescopes please sketch and show depths.

GROUND LEVEL

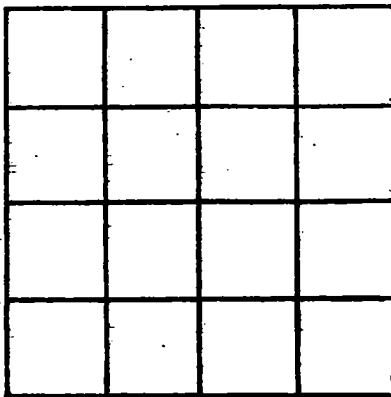

SECTION _____

Please indicate well location X.

ADDITIONAL INFORMATION

A series of horizontal lines providing space for additional information.

If more than one screen, show locations of each on sketch.