

HARRISON
G 209
12-17-73

MISSISSIPPI
BOARD OF WATER COMMISSIONERS CODED
416 North State Street
Jackson, Mississippi 39201
WATER WELL DRILLERS LOG

12-17-73
date well completed

R. J. Moore
firm name


HARRISON
county well located

LANDOWNER: <u>G. W. Huddle</u>	description of formations encountered	from	to
<u>RT 2 Box 78 W</u>	<u>TOP SOIL</u>	<u>0</u>	<u>10</u>
<u>Gulfport, Miss</u> (mailing address)	<u>TOP SAND</u>	<u>10</u>	<u>25</u>
WELL LOCATION: sec. <u>20</u> T. <u>6</u> N. R. <u>11</u> E <u>S</u> <u>W</u>	<u>Blue Clay</u>	<u>25</u>	<u>200</u>
<u>1</u> miles <u>W</u> of <u>LYNN</u>	<u>FINE Blue Sand</u>	<u>200</u>	<u>220</u>
(distance) (direction) (nearest town)	<u>Blue Clay</u>	<u>220</u>	<u>450</u>
WELL PURPOSE: (<u>home</u> , irrigation, municipal, industrial)	<u>Coarse Gray Sand</u>	<u>450</u>	<u>480</u>
WELL COMPLETION DATA:			
(1) diameter (inches) <u>2"</u>			
(2) total depth (feet) <u>480'</u>			
(3) static water level (feet) <u>48'</u> <u>below</u> top of ground.			
(4) casing <u>galv</u> , <u>470'</u> (material) (depth)			
<u> </u> if telescope see back. (size)			
(5) screen <u>10'</u> , <u>470'</u> (length) (depth to top)			
<u>2"</u> , <u>SS</u> (size) (material)			
(6) pump <u>1</u> , <u>8</u> (HP) (yield gpm)			
<u>E</u> (type power)			
(7) electric log <u> </u> (yes or no)			
<u> </u> (organization running log)			
(8) how well bottom plugged <u> </u> <u>Full screen</u>			
DRILLERS REMARKS: <u> </u>			

CODED

If well telescopes please sketch and show depths.

GROUND LEVEL

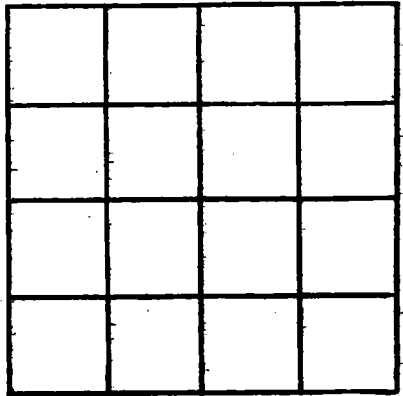

SECTION _____

Please indicate well location X.

ADDITIONAL INFORMATION

A series of horizontal lines for recording additional information, starting below the 'ADDITIONAL INFORMATION' header and extending to the bottom of the page.

If more than one screen, show locations of each on sketch.