

HARRISON
G 213
8-2-73

MISSISSIPPI
 BOARD OF WATER COMMISSIONERS
 416 North State Street
 Jackson, Mississippi 39201

WATER WELL DRILLERS LOG

CODED

8-2
 date well completed

1973 Mt B Drilling Co. Inc.
 firm name

Harrison
 county well located

LANDOWNER: PAT McCaffrey

29 33rd

Gulfport, Miss.
 (mailing address)

WELL LOCATION:

sec. 36 T. 6 S. R. 11 E.
6 miles NE of Gulfport
 (distance) (direction) (nearest town)

WELL PURPOSE: Home
 (home, irrigation, municipal, industrial)

WELL COMPLETION DATA:

- (1) diameter (inches) 4 1/2
 (2) total depth (feet) _____
 (3) static water level (feet) 4 ^{below} top of ground. above
 (4) casing 1 1/2" PVC - Balance 2" Steel
 (material) (depth)

4 1/2 if telescope see back.
 (size)

(5) screen 10ft 1130
 (length) (depth to top)

2" 2" Steel U-lube bar
 (size) (material) 100ft

(6) pump 1 Sub 20
 (HP) (yield gpm)

220V 10
 (type power)

(7) electric log No
 (yes or no)

(organization running log)

(8) how well bottom plugged
2" Back Wash Valve

DRILLERS REMARKS:

description of formations encountered

from

to

Red & white clay	0	15
White clay	15	25
Sand	25	45
White clay	45	50
Sand	50	95
Blue clay	95	98
Sand	98	120
Blue clay	120	170
Sand fine	170	180
Blue clay	180	215
Sand fine	215	225
Blue clay	225	345
Sand fine	345	355
Blue clay	355	360
Sand	360	363
Blue clay	363	660
Sand	660	665
Blue clay	665	815
Sand	815	825
Blue clay	825	1110
Sand - fine	1110	1140
Blue clay	1140	+


If well telescopes please sketch and show depths.

GROUND LEVEL

140 FT
4" PVC
4 x 1/2" 125' →
Lead Pack^{ft} 140 FT

2" Colv.
Pipe

2" x 10 FT
100' S&P
Screen
2" Brass
B.W. Valve
← 1130 FT
← 1140 FT

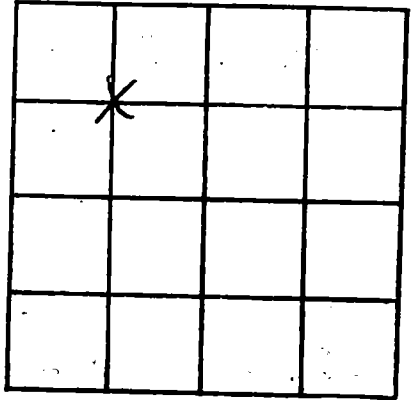

SECTION 36

Please indicate well location X.

ADDITIONAL INFORMATION

If more than one screen,
show locations of each on sketch.