

MISSISSIPPI  
BOARD OF WATER COMMISSIONERS  
416 North State Street  
Jackson, Mississippi 39201

CODED

WATER WELL DRILLERS LOG

G 215  
HARRISON  
3-21-74

3-21 1974 Mc Hill Well Works Harrison  
date well completed firm name county well located

LANDOWNER: <u>Bennie Holston</u>	Description of formations encountered	from	to
Rt. 1, Box 42 Gulfport, Miss. (mailing address)	<u>Clay</u>	<u>0</u>	<u>20</u>
	<u>Sand</u>	<u>20</u>	<u>46</u>
	<u>Blue clay</u>	<u>46</u>	<u>193</u>
	<u>slush</u>	<u>173</u>	<u>208</u>
	<u>Blue clay</u>	<u>208</u>	<u>296</u>
	<u>slush</u>	<u>296</u>	<u>340</u>
	<u>Blue clay</u>	<u>340</u>	<u>399</u>
	<u>Coarse sand</u>	<u>399</u>	<u>430</u>

WELL LOCATION:  
sec. 19 T. 6 N R. 11 E  
1 miles W of Tomas  
(distance) (direction) (nearest town)

WELL PURPOSE: Home  
(home, Irrigation, municipal, Industrial)

WELL COMPLETION DATA:

(1) diameter (inches) 2"

(2) total depth (feet) 430

(3) static water level (feet) 52' below top of ground.

(4) casing gal. (material), 420' (depth)

5" (size) if telescope see back.

(5) screen 10" (length), 55' (depth to top)

2" (size), 55' (material)

(6) pump 1 (HP), 8 (yield gpm)

electric (type power)

(7) electric log No. (yes or no)

(organization running log)

(8) how well bottom plugged sand

shark

CODED


CODED

DRILLERS REMARKS:

MISS. Bd. of Water  
1974

If well telescopes please sketch and show depths.

GROUND LEVEL

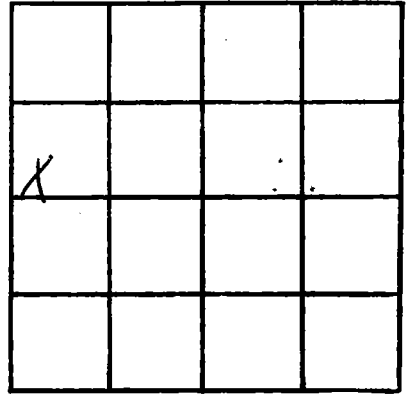

SECTION 19

Please indicate well location X.

ADDITIONAL INFORMATION

If more than one screen, show locations of each on sketch.