

HARRISON
 6218
 8/28/74

MISSISSIPPI
 BOARD OF WATER COMMISSIONERS
 416 North State Street
 Jackson, Mississippi 39201

WATER WELL DRILLERS LOG

28 Aug 1974 BRYANT Well Co. HARRISON
 date well completed firm name county well located

LANDOWNER: D.L. McKNIGHT
RT 5 Box 720-B
Gulfport, Ms. 39501
 (mailing address)

description of formations encountered	from	to
Red clay	0	10
Red sand	10	14
Red clay	14	23
Red sandy clay	23	27
White sand	27	105
Blue clay	105	261
Good sand	261	301

WELL LOCATION:
 sec. 36 T. 6 S. R. 11 W.
3 miles N of Gulfport
 (distance) (direction) (nearest town)

WELL PURPOSE: HOME
 (home, irrigation, municipal, industrial)


WELL COMPLETION DATA:

- (1) diameter (inches) 2
- (2) total depth (feet) 301
- (3) static water level (feet) 32 below top of ground.
- (4) casing PVC, 291
 (material) (depth)
 (size) If telescope see back.
- (5) screen 10, 291
 (length) (depth to top)
2, PVC
 (size) (material)
- (6) pump 1/2, 8
 (HP) (yield gpm)
ELECT
 (type power)
- (7) electric log No
 (yes or no)
 (organization running log)

(8) how well bottom plugged PVC Back
PRESSURE VALVE

DRILLERS REMARKS: PVC Back

CODED

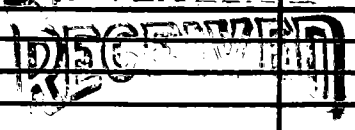

SEP 20 1974

If well telescopes please sketch and show depths.

GROUND LEVEL

			X

SECTION 36

Please indicate well location X.

ADDITIONAL INFORMATION

If more than one screen, show locations of each on sketch.