

Harrison
G 219
11-20-73

MISSISSIPPI
 BOARD OF WATER COMMISSIONERS
 416 North State Street
 Jackson, Mississippi 39201

CODED

WATER WELL DRILLERS LOG

November 20 19 73 H.A. Hadwier Well Works HARRISON
 date well completed firm name county well located


LANDOWNER:	description of formations encountered	from	to
<u>Knapp</u>			
<u>Biloxi River Estates</u>	<u>yellow clay</u>	<u>0</u>	<u>40</u>
<u>Gulfport, Miss.</u>	<u>yellow sand</u>	<u>40</u>	<u>95</u>
(mailing address)	<u>yellow clay</u>	<u>95</u>	<u>150</u>
WELL LOCATION:	<u>blue clay</u>	<u>150</u>	<u>415</u>
sec. <u>2</u> T. <u>6</u> S. R. <u>11</u> W.	<u>blue sand</u>	<u>415</u>	<u>475</u>
<u>10</u> miles <u>NW</u> of <u>Hoolmarker</u>			
(distance) (direction) (nearest town)			
WELL PURPOSE: <u>Home</u>			
(home, irrigation, municipal, industrial)			
WELL COMPLETION DATA:			
(1) diameter (inches) <u>2 inch</u>			
(2) total depth (feet) <u>475 ft.</u>			
(3) static water level (feet) <u>45</u> below top of ground.			
(4) casing <u>Galv.</u> <u>465 ft.</u>			
(material) (depth)			
<u>2 inch</u> If telescope see back.			
(size)			
(5) screen <u>10 ft.</u> <u>465 ft.</u>			
(length) (depth to top)			
<u>2 inch</u> <u>STAINLESS STEEL</u>			
(size) (material)			
(6) pump <u>1</u> <u>0</u>			
(HP) (yield gpm)			
<u>Electric</u>			
(type power)			
(7) electric log <u>NO</u>			
(yes or no)			
(organization running log)			
(8) how well bottom plugged <u>Ball Check</u>			
DRILLERS REMARKS:			

RECEIVED
 NOV 24 1974

MISS. BD. OF WATER COMM.

If well telescopes please sketch and show depths.

GROUND LEVEL

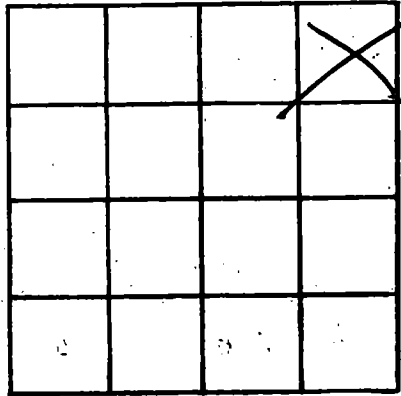

SECTION 2

Please indicate well location X.

ADDITIONAL INFORMATION

If more than one screen, show locations of each on sketch.