

Harrison
G220
8-30-73

MISSISSIPPI
 BOARD OF WATER COMMISSIONERS
 416 North State Street
 Jackson, Mississippi 39201

CODEP

WATER WELL DRILLERS LOG

August 30 1973 H.A. Ladnier's Well Works Harrison
 date well completed firm name county well located

LANDOWNER: <u>Johny Tidmore</u> <u>Biloxi River Estates</u> <u>Culport, Miss.</u> <small>(mailing address)</small>	description of formations encountered	from	to
WELL LOCATION: sec. <u>2</u> T. <u>6</u> S. R. <u>11</u> W. <u>10</u> miles <u>NW</u> of <u>Woodmarket</u> <small>(distance) (direction) (nearest town)</small>	<u>yellow clay</u> <u>yellow sand</u> <u>yellow clay</u> <u>blue clay</u> <u>blue sand</u>	<u>0</u> <u>40</u> <u>90</u> <u>170</u> <u>330</u>	<u>40</u> <u>90</u> <u>170</u> <u>330</u> <u>390</u>
WELL PURPOSE: <u>HOME</u> <small>(home, irrigation, municipal, industrial)</small>			
WELL COMPLETION DATA:			
(1) diameter (inches) <u>2 inch</u>			
(2) total depth (feet) <u>390 FT.</u>			
(3) static water level (feet) <u>60</u> <small>below above</small> top of ground.			
(4) casing <u>Galv.</u> <u>380 FT.</u> <small>(material) (depth)</small>			
<u>2 inch</u> if telescope see back. <small>(size)</small>			
(5) screen <u>10 ft.</u> <u>380 FT.</u> <small>(length) (depth to top)</small>			
<u>2 inch</u> <u>STAINLESS STEEL</u> <small>(size) (material)</small>			
(6) pump <u>1</u> <u>8</u> <small>(HP) (yield gpm)</small>			
<u>Electric</u> <small>(type power)</small>			
(7) electric log <u>NO</u> <small>(yes or no)</small>			
<small>(organization running log)</small>			
(8) how well bottom plugged <u>Ball Check</u>			
DRILLERS REMARKS:			


RECEIVED

NOV - 4 1974

MISS. BD. OF WATER COMM

If well telescopes please sketch and show depths.

GROUND LEVEL

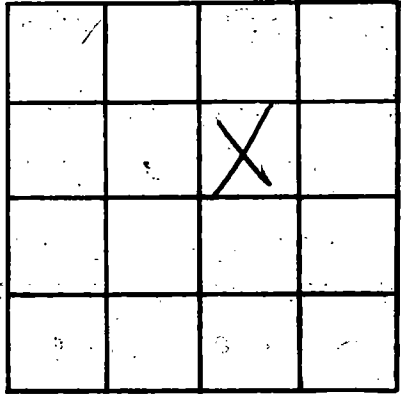

SECTION 2

Please indicate well location X.

ADDITIONAL INFORMATION

If more than one screen, show locations of each on sketch.