

**Harrison**  
**G 221**  
**9-7-73**

MISSISSIPPI  
 BOARD OF WATER COMMISSIONERS  
 416 North State Street  
 Jackson, Mississippi 39201

**CODEL**

**WATER WELL DRILLERS LOG**

September 7, 1973 H.A. Hadwice's Well Works Harrison  
 date well completed firm name county well located

LANDOWNER:	description of formations encountered	from	to
<u>Clark</u>			
<u>John Clark Road</u>			
<u>Gulfport, Miss.</u> (mailing address)	<u>yellow clay</u>	<u>0</u>	<u>40</u>
	<u>yellow sand</u>	<u>40</u>	<u>60</u>
	<u>yellow clay</u>	<u>60</u>	<u>140</u>
	<u>blue clay</u>	<u>140</u>	<u>265</u>
	<u>blue sand</u>	<u>265</u>	<u>300</u>
<b>WELL LOCATION:</b>			
sec. <u>2</u> T. <u>16</u> S. R. <u>11</u> W.			
<u>12</u> miles <u>SW</u> of <u>LYMAN</u>			
(distance) (direction) (nearest town)			
<b>WELL PURPOSE:</b> <u>HOME</u> (home, irrigation, municipal, industrial)			
<b>WELL COMPLETION DATA:</b>			
(1) diameter (inches) <u>2 1/2</u> inch			
(2) total depth (feet) <u>300 ft.</u>			
(3) static water level (feet) <u>4.5</u> below top of ground.			
(4) casing <u>Galv.</u> , <u>290 ft.</u> (material) (depth)			
<u>2 1/2</u> inch (size) If telescope see back.			
(5) screen <u>10 ft.</u> , <u>290 ft.</u> (length) (depth to top)			
<u>2 1/2</u> inch, <u>Stainless Steel</u> (size) (material)			
(6) pump <u>1</u> (HP) <u>8</u> (yield gpm)			
<u>Electric</u> (type power)			
(7) electric log <u>NO</u> (yes or no)			
(organization running log)			
(8) how well bottom plugged <u>Ball Check</u>			
<b>DRILLERS REMARKS:</b>			


**RECEIVED**

NOV - 4 1974

MISS. BD. OF WATER COMM

If well telescopes please sketch and show depths.

GROUND LEVEL

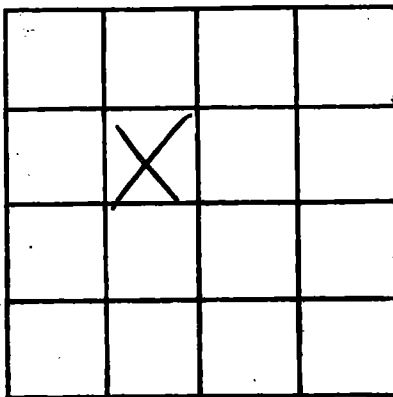

SECTION 2

Please indicate well location X.

ADDITIONAL INFORMATION

If more than one screen,  
show locations of each on sketch.