

HARRISON  
 G 223  
 2-6-75

MISSISSIPPI  
 BOARD OF WATER COMMISSIONERS  
 416 North State Street  
 Jackson, Mississippi 39201

CODED

WATER WELL DRILLERS LOG

6 FEB 1975 Bayant Well Co HARRISON  
 date well completed firm name county well located

LANDOWNER: M.H. Richards  
PO Box 6346  
Gulfport, Ms. 39501  
 (mailing address)

description of formations encountered	from	to
<u>CLAY</u>	<u>0</u>	<u>18</u>
<u>SAND</u>	<u>18</u>	<u>33</u>
<u>CLAY</u>	<u>33</u>	<u>79</u>
<u>SAND</u>	<u>79</u>	<u>102</u>
<u>BLUE GRAVEL</u>	<u>102</u>	<u>275</u>
<u>GOOD SAND</u>	<u>275</u>	<u>300</u>

WELL LOCATION:  
 sec 36 T 6 S R 11 W  
4 miles N of Gulfport  
 (distance) (direction) (nearest town)

WELL PURPOSE: HOME  
 (home, irrigation, municipal, industrial)

WELL COMPLETION DATA:

(1) diameter (inches) 2

(2) total depth (feet) 300

(3) static water level (feet) 32 below top of ground.

(4) casing PVC, 290,  
 (material) (depth)  
 (size) If telescope see back.

(5) screen 10', 290  
 (length) (depth to top)  
2", PVC  
 (size) (material)


(6) pump 1 10  
 (HP) (yield gpm)  
ELECT  
 (type power)

(7) electric log NO  
 (yes or no)

(organization running log)

(8) how well bottom plugged PVC  
BACK PRESERVE

DRILLERS REMARKS:

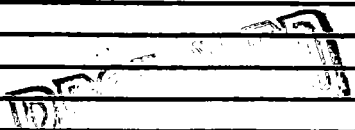

FEB 24 1975

MISS. BD. OF WATER COMM

If well telescopes please sketch and show depths.

GROUND LEVEL

			X

SECTION 36

Please indicate well location X.

ADDITIONAL INFORMATION

If more than one screen, show locations of each on sketch.