

Harrison
G 224
2-14-75

MISSISSIPPI **CODED**
BOARD OF WATER COMMISSIONERS
416 North State Street
Jackson, Mississippi 39201
WATER WELL DRILLERS LOG

2-14-1975 Sutter Well Works Harrison
date well completed firm name county well located

LANDOWNER: Stanley Malek

Rt. 2 Box 78-W

Gulfport, Miss.
(mailing address)

WELL LOCATION:

sec. 32 T 6 S R 11 W
3 miles south of Lyman
(distance) (direction) (nearest town)

WELL PURPOSE: home
(home, irrigation, municipal, industrial)

WELL COMPLETION DATA:

- (1) diameter (inches) 4" x 2"
(2) total depth (feet) 539'
(3) static water level (feet) 67' below top of ground.
(4) casing galv. 528'
(material) (depth)
4" & 2"
(size) if telescope see back.
(5) screen 11' 528'
(length) (depth to top)
2" stainless steel
(size) (material)
(6) pump owner's
(HP) (yield gpm)
elec.
(type power)
(7) electric log no
(yes or no)
(organization running log)
(8) how well bottom plugged B.P. Valve


description of formations encountered

from

to

Sand	0	30
Clay	30	91
Sand	91	134
Clay	134	459
Sand	459	539

CODED

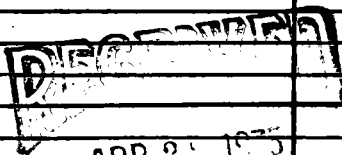

DRILLERS REMARKS:

MISS. BD. OF WATER COMM

