

Harrison  
 G 225  
 3/22/74

MISSISSIPPI  
 BOARD OF WATER COMMISSIONERS  
 416 North State Street  
 Jackson, Mississippi 39201

CODED

WATER WELL DRILLERS LOG

3/22 date well completed 1974 P. Smith & Co. Well Harrison<sup>6</sup> firm name county well located

LANDOWNER: L. E. Equip description of formations encountered from to  
G. Hy 49 Lyman  
 (mailing address) red clay 0 90'  
 WELL LOCATION: see 28 T 6 R 11 E 135 white clay 90' 160'  
0 miles SE side of Lyman blue pipe clay 160' 350'  
 (distance) (direction) (nearest town)

WELL PURPOSE: Home Over water sand 350' 376'  
 (home, irrigation, municipal, industrial) 2 6 ft water sand


- WELL COMPLETION DATA:
- (1) diameter (inches) 2"
  - (2) total depth (feet) 376'
  - (3) static water level (feet) 45 below top of ground.
  - (4) casing 2" galv 376'  
 (material) (depth)  
2' if telescope see back.  
 (size)
  - (5) screen 5 371  
 (length) (depth to top)  
2 all SS-S  
 (size) (material)
  - (6) pump 1 9  
 (HP) (yield gpm)  
Elc  
 (type power)
  - (7) electric log Y  
 (yes or no)  
Y  
 (organization running log)
  - (8) how well bottom plugged Sand  
2"

DRILLERS REMARKS:

REGISTERED

If well telescopes please sketch and show depths.

GROUND LEVEL

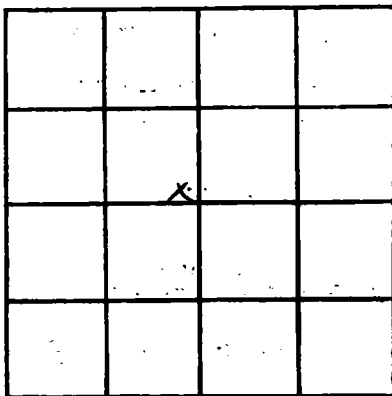

SECTION 28

Please indicate well location X.

ADDITIONAL INFORMATION

If more than one screen, show locations of each on sketch.