

MISSISSIPPI DEPARTMENT OF NATURAL RESOURCES

Bureau of Land and Water Resources

Southport Mall

P.O. Box 10631

Jackson, Mississippi 39209

WATER WELL DRILLERS LOG

COASTAL DRILLING & SERVICE CO.

CODED

ROUTE 1 BOX 118

BILOXI, MISS. 39532

Harrison  
county well located

HARRISON  
G 242  
6-27-79

6/27/79  
date well completed

LANDOWNER: Bell Jones

Old Hwy 49  
Hwy 11  
(mailing address)

WELL LOCATION:

sec. 7 T. 6 N. R. 11 E. W. 3  
3 1/2 miles North Jones  
(distance) (direction) (nearest town)

WELL PURPOSE: Home  
(home, irrigation, municipal, industrial)

WELL COMPLETION DATA:

- (1) diameter (inches) 4"
- (2) total depth (feet) 145'
- (3) static water level (feet) 55' below above top of ground.
- (4) casing PVC, 130'  
(material) (depth)  
(size) If telescope see back.
- (5) screen 15', 130'  
(length) (depth to top)  
2", PVC  
(size) (material)
- (6) pump One, 20  
(HP) (yield gpm)  
Ele  
(type power)
- (7) electric log no  
(yes or no)

(organization running log)

(8) how well bottom plugged  
2" Hard Wash Water

DRILLERS REMARKS: 19-B

description of formations encountered	from	to
<u>Top Soil</u>	<u>1</u>	<u>3</u>
<u>Red Clay</u>	<u>3</u>	<u>14</u>
<u>Blue Sand</u>	<u>14</u>	<u>25</u>
<u>Silt Blue Clay</u>	<u>25</u>	<u>30</u>
<u>Hard Blue Clay</u>	<u>30</u>	<u>90</u>
<u>fine water sand</u>	<u>90</u>	<u>115</u>
<u>hard water sand</u>	<u>115</u>	<u>145</u>


DEPT. OF NATURAL RESOURCES  
BUREAU OF LAND & WATER RESOURCES

OCT 31 1980

RECEIVED

If well telescopes please sketch and show depths.

GROUND LEVEL

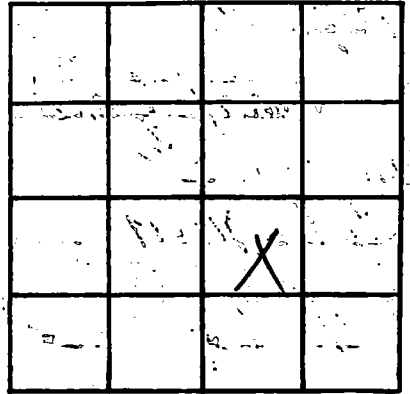

SECTION \_\_\_\_\_

Please indicate well location, X.

ADDITIONAL INFORMATION

If more than one screen, show locations of each on sketch.