

MISSISSIPPI DEPARTMENT OF NATURAL RESOURCES

Bureau of Land and Water Resources

Southport Mall

P.O. Box 10631

Jackson, Mississippi 39209

WATER WELL DRILLERS LOG

COASTAL DRILLING & SERVICE CO.

CODED

HARRISON  
G 244  
8-15-80

8/15/80  
date well completed

ROUTE 1 BOX 618  
Bilbo, Miss. 39532

Harrison  
county well located

LANDOWNER: *John Seagraves*  
*Heller Fork Smith Sr*  
*4414 Min*  
(mailing address)

description of formations encountered	from	to
Top Soil	1	3
Red Clay	3	18
Coarse white Sand	18	60
Soft Red Clay	60	95
Soft Blue Clay	95	170
Coarse white Sand	170	215
Soft Blue Clay	215	310
Hard Blue Clay	310	460
fine white Sand	460	490
good water Sand	490	520

WELL LOCATION:  
sec 27 T 6 N R 11 E  
*(2) 1/4 NE Twp*  
(distance) (direction) (nearest town)

WELL PURPOSE: *home*  
(home, irrigation, municipal, industrial)

WELL COMPLETION DATA:

(1) diameter (inches) *4 1/2"*

(2) total depth (feet) *520'*

(3) static water level (feet) *70'* below  
top of ground

(4) casing *PVC* *505'*  
(material) (depth)  
*4 1/2"* if telescope see back.  
(size)

(5) screen *15'* *505'*  
(length) (depth to top)  
*2"* *PVC*  
(size) (material)

(6) pump *1 1/2* *25*  
(HP) (yield gpm)  
*9kw*  
(type power)

(7) electric log *no*  
(yes or no)

(organization running log)

(8) how well bottom plugged  
*2 feet with talcum*

DRILLERS REMARKS: *19-6*

DEPT. OF NATURAL RESOURCES  
BUREAU OF LAND & WATER RESOURCES

JAN 23 1981

RECEIVED

If well telescopes please sketch and show depths.


GROUND LEVEL

200' 4" PVC Casing

305' 2" PVC Casing

15' 2" PVC Screen

2' Rock Wash Screen  
19-B

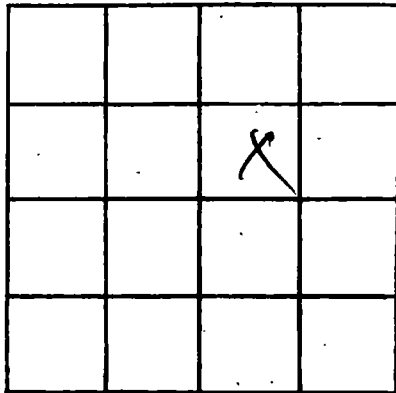

SECTION \_\_\_\_\_

Please indicate well location X.

ADDITIONAL INFORMATION

If more than one screen, show locations of each on sketch.