

MISSISSIPPI DEPARTMENT OF NATURAL RESOURCES

Bureau of Land and Water Resources

Southport Mall

P.O. Box 10631

Jackson, Mississippi 39209

WATER WELL DRILLERS LOG
COASTAL DRILLING & SERVICE CO.

CODED

HARRISON
G 245
8-11-81

ROUTE 1 BOX 618

firm name
BILOXI MISS. 39532

county well located

date well completed

LANDOWNER: Robert Gregory

description of formations encountered

from to

Jala Clark Road
Spt. min
(mailing address)

<u>Top soil</u>	<u>1</u>	<u>3</u>
<u>Red Clay</u>	<u>3</u>	<u>15</u>
<u>Coarse white sand</u>	<u>15</u>	<u>65</u>
<u>Spt blue clay</u>	<u>65</u>	<u>110</u>
<u>Super sand shale</u>	<u>110</u>	<u>180</u>
<u>Coarse white sand</u>	<u>180</u>	<u>240</u>
<u>Spt blue clay</u>	<u>240</u>	<u>310</u>
<u>hard blue clay</u>	<u>310</u>	<u>510</u>
<u>fine white sand</u>	<u>510</u>	<u>570</u>
<u>good water sand</u>	<u>570</u>	<u>580</u>

WELL LOCATION:

sec 31 T 6N R 11E
S W
Flat Branch
(distance) (direction) (nearest town)

WELL PURPOSE: home
(home, irrigation, municipal, industrial)

WELL COMPLETION DATA:


- (1) diameter (inches) 4 1/2"
- (2) total depth (feet) 580'
- (3) static water level (feet) 75' below above top of ground.
- (4) casing PVC, 565' (material), (depth)
4 1/2" if telescope see back. (size)
- (5) screen 15', 565' (length), (depth to top)
2" (size), PVC (material)
- (6) pump 1 1/2 25 (HP), (yield gpm)
Ele (type power)
- (7) electric log no (yes or no)

(organization running log)

(8) how well bottom plugged
2' best water value

DRILLERS REMARKS: 19-B

CODED

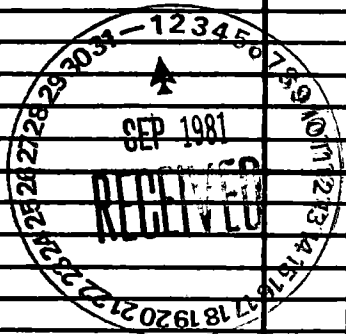

If well telescopes please sketch and show depths.

GROUND LEVEL


200' 4" PVC Casing

365' 2" PVC Casing

15' 2" PVC Screen

2" Gal Wash Valve
19-B

If more than one screen,
show locations of each on sketch.

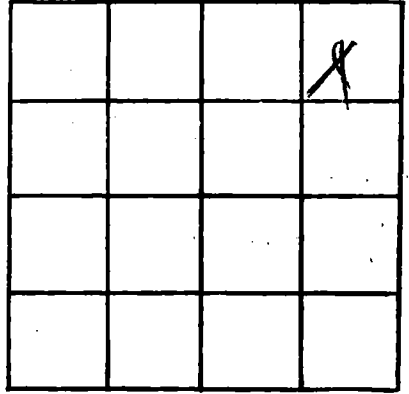

SECTION _____

Please indicate well location X.

ADDITIONAL INFORMATION

Multiple horizontal lines for additional information.