

MISSISSIPPI DEPARTMENT OF NATURAL RESOURCES
Bureau of Land and Water Resources
 Southport Mall
 P.O. Box 10631
 Jackson, Mississippi 39209
WATER WELL DRILLERS LOG

HARRISON
G246
7/28/82

7-28-82 19 Lyman Well Company Harrison
 date well completed firm name county well located

ANDOWNER Dara Hill Farms
Rt. 3, Box 678
Gulfport, MS 39503
 (mailing address)

WELL LOCATION:
 sec. 31 T. 6 R. 11
10 miles NW of Gulfport
 (distance) (direction) (nearest town)

WELL PURPOSE: home
 (home, irrigation, municipal, industrial)

- WELL COMPLETION DATA:
- (1) diameter (inches) 4 x 2
- (2) total depth (feet) 559'
- (3) static water level (feet) 80 below top of ground.
- (4) casing PVC 529'
 (material) (depth)
4 x 2 if telescope see back.
 (size)
- (5) screen 30' 529'
 (length) (depth to top)
2" PVC
 (size) (material)
- (6) pump 1 1/2 34
 (HP) (yield gpm)
electric
 (type power)
- (7) electric log no
 (yes or no)
no
 (organization running log)
- (8) how well bottom plugged sand
seal

description of formations encountered	depth	
	from	to
red clay	0	60
red sand	61	80
gumbo clay	81	120
red sand & clay	121	260
blue gumbo clay	261	465
good sand	466	559

CODE 17

DEPT. OF NATURAL RESOURCES
 BUREAU OF LAND & WATER RESOURCES

FEB 28 1983

RECEIVED

DRILLERS REMARKS:

HARRISON
County

If well telescopes please
sketch and show depths.

G-246


GROUND LEVEL

240' 4"
Sch. 40
PVC casing

289' 2"
Sch. 40
PVC casing

30' 2"
Sch. 80
PVC screen

PVC
sand shark

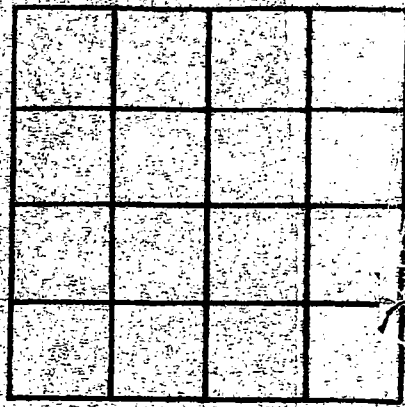

SECTION 31

Please indicate well location X.

ADDITIONAL INFORMATION

DEPT. OF NATURAL RESOURCES
BUREAU OF LAND & WATER RESOURCES

FEB 28 1983

RECEIVED