

MISSISSIPPI DEPARTMENT OF NATURAL RESOURCES

Bureau of Land and Water Resources

Southport Mall

P.O. Box 10631

Jackson, Mississippi 39209

WATER WELL DRILLERS LOG

CODED

HARRISON Co
G 248
2-9-84

2/9 1984 date well completed
Braden, Inc. firm name
Harrison county well located

LANDOWNER	description of formations encountered	from	to
Lester Horat Rt. 3, Box 740 Gulfport, Ms 39503 (mailing address)	clay	0	20
	clay	20	140
	sand	140	180
	blue clay	180	200
	clay	200	480
	sand	480	560
CODED			
WELL LOCATION: sec. <u>32</u> T. <u>6</u> S. R. <u>11</u> W. miles <u>in</u> of <u>Lynon</u> (distance) (direction) (nearest town)			
WELL PURPOSE: <u>home</u> (home, irrigation, municipal, industrial)			
WELL COMPLETION DATA:			
(1) diameter (inches) <u>4" X 2"</u>			
(2) total depth (feet) <u>560</u>			
(3) static water level (feet) <u>40</u> below top of ground.			
(4) casing <u>PVC</u> , <u>510</u> , (material) (depth) <u>4 X 2</u> if telescope see back. (size)			
(5) screen <u>10 ft</u> , <u>510 ft</u> , (length) (depth to top) <u>2"</u> , <u>PVC underbar</u> (size) (material)			
(6) pump <u>1</u> , <u>25</u> (HP) (yield gpm) <u>230V</u> (type power)			
(7) electric log <u>no</u> (yes or no) (organization running log)			
(8) how well bottom plugged <u>PVC</u> <u>sandshark</u>			
DRILLERS REMARKS: <u>40'</u> <u>tailpipe</u>			

RECEIVED
 FEB 21 1984
 MISSISSIPPI DEPARTMENT OF NATURAL RESOURCES
 BUREAU OF LAND & WATER RESOURCES

If well telescopes please sketch and show depths.


GROUND LEVEL

200'
4" PVC

310'
2" PVC

10' of 2" PVC screens

40 ft tail pipe

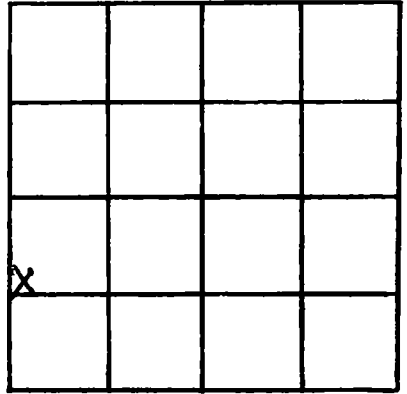

SECTION 32

Please indicate well location X.

ADDITIONAL INFORMATION

If more than one screen, show locations of each on sketch.