

CODED

MISSISSIPPI
BOARD OF WATER COMMISSIONERS
416 North State Street
Jackson, Mississippi 39201

CODED

WATER WELL DRILLERS LOG

Harrison
G 22635
4-15-74

4/15 1974 COASTAL DRILLING & SERVICE CO. Harrison
date well completed ROUTE 1 BOX 678 county well located

LANDOWNER Mr. D. C. BLOOM, MISS.
Rt 3 Box 263 B
4pt Davis
(mailing address)
WELL LOCATION:
sec 31 T 6 N R 11 E 135
S W
(3) Three miles N-W of Sardis
(distance) (direction) (nearest town)

description of formations encountered	from	to
<u>Top Soil</u>	<u>3</u>	<u>3</u>
<u>Red Shales</u>	<u>3</u>	<u>15</u>
<u>white sand</u>	<u>15</u>	<u>36</u>
<u>Sand</u>	<u>36</u>	<u>40</u>
<u>Shells</u>	<u>40</u>	<u>42</u>
<u>Blue Shale</u>	<u>42</u>	<u>100</u>
<u>fine white sand</u>	<u>100</u>	<u>200</u>
<u>hard blue clay</u>	<u>200</u>	<u>410</u>
<u>fine white sand</u>	<u>410</u>	<u>440</u>
<u>concretionary sand</u>	<u>440</u>	<u>463</u>

WELL PURPOSE: Home
(home, irrigation, municipal, industrial)


WELL COMPLETION DATA:

- (1) diameter (inches) 2"
- (2) total depth (feet) 463'
- (3) static water level (feet) 48 below above top of ground.
- (4) casing POC, 453'
(material) (depth)
 if telescope see back.
(size)
- (5) screen 10', 453'
(length) (depth to top)
2", POC
(size) (material)
- (6) pump (HP) (yield gpm)
Ele
(type power)
- (7) electric log no
(yes or no)
 (organization running log)

CODED

(8) how well bottom plugged
2" lead with holes


DRILLERS REMARKS:

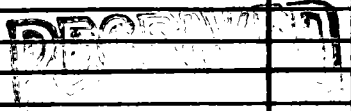

JUL 17 1975

If well telescopes please sketch and show depths.

GROUND LEVEL

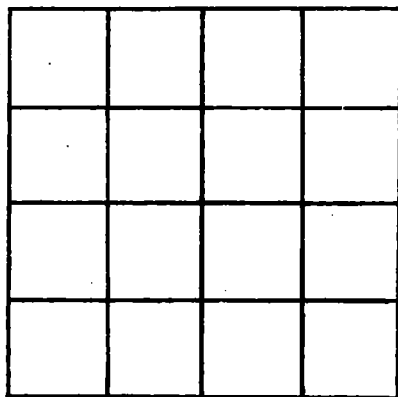

SECTION _____

Please indicate well location X.

ADDITIONAL INFORMATION

If more than one screen, show locations of each on sketch.