

MISSISSIPPI DEPARTMENT OF NATURAL RESOURCES

Bureau of Land and Water Resources

Southport Mall

P.O. Box 10631

Jackson, Mississippi 39209

WATER WELL DRILLERS LOG

CQDEB

<i>Harrison</i>
G 253
8-10-83

8-10-1983 *McNeil Wells, Inc. Harrison*
 date well completed firm name county well located

LANDOWNER: *Bruce Sigler*
659 A Shorecrest Drive
Woolmarket, Ms
 (mailing address)

description of formations encountered	from	to
<i>mud</i>	<i>0</i>	<i>20</i>
<i>sand</i>	<i>20</i>	<i>60</i>
<i>mud</i>	<i>60</i>	<i>360</i>
<i>sand</i>	<i>360</i>	<i>520</i>

WELL LOCATION:
 sec. *12* T. *6* N R. *11* E
10 miles *SW* of *Bunt*
 (distance) (direction) (nearest town)

WELL PURPOSE:
 (home, irrigation, municipal, industrial)

WELL COMPLETION DATA:

- (1) diameter (Inches) *2"*
- (2) total depth (feet) *520'*
- (3) static water level (feet) *30'* below above top of ground.
- (4) casing *40 PVC, 510'*
 (material) (depth)
 (size) If telescope see back.
- (5) screen *10', 510'*
 (length) (depth to top)
2", 80 PVC, 6-shot
 (size) (material)
- (6) pump *1* *12*
 (HP) (yield gpm)
electric
 (type power)
- (7) electric log *no*
 (yes or no)

DEPT. OF NATURAL RESOURCES
 BUREAU OF LAND & WATER RESOURCES

JAN 18 1984


RECEIVED

(organization running log)
 (8) how well bottom plugged *sand seal*

DRILLERS REMARKS:

If well telescopes please sketch and show depths.

GROUND LEVEL

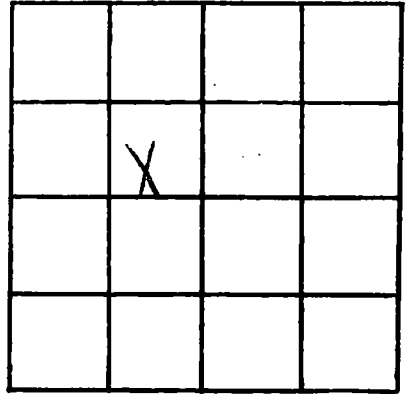

SECTION 12

Please indicate well location X.

ADDITIONAL INFORMATION

If more than one screen, show locations of each on sketch.