

HAR.

LG 254

MISSISSIPPI BOARD OF WATER COMMISSIONERS

5-23-66

U 413 501

WATER WELL DRILLERS LOG

CODED

Date: 5-23, 1966, Driller: C.T. Switzer Well Co. County: Harrison

(When well drilled)

(Name)

(Where well is located)

		Description & Color of Materials Sand, Clay, Red Clay, Shell, etc.	Thick- ness Feet	Depth Feet
(1) Owner of Land: <u>John Withers</u> (Name)		clay	0	21
<u>John Clark Rd., Sulphur</u> (Address)		sand, red	21	41
(2) Location: <u>1/4</u> , <u>1/4</u> , <u>Sec 6</u> <u>6 R</u> <u>1 N</u>		clay	41	53
<u>1/4</u> miles, of <u>1 N</u> (distance) (direction) (Nearest Town)		sand	53	71
(3) Topography: <u>X</u> (Hilly) (Flat) (Level)		clay	71	161
(4) Purpose of Well: <u>domestic</u> (Domestic Irrigation Municipal, Industrial, Other)		sand	161	216

CODED

Information upon completion of well:

- (1) Diameter 3 x 2 inches.
- (2) Total Depth 216 feet.
- (3) Water Level 43 feet below top of ground.
- (4) Cased to 216', Size 3 x 2" top 84' - 3"
- (5) Screen: Size 8 ga SS, Length 10'
- (6) Were any formations sealed against pollution?
X yes, no.

If YES depth of formation _____


Why Health Dept. Regments.

Drillers Remarks: _____

Yield in gpm: _____

Size pump: _____

Type power: _____

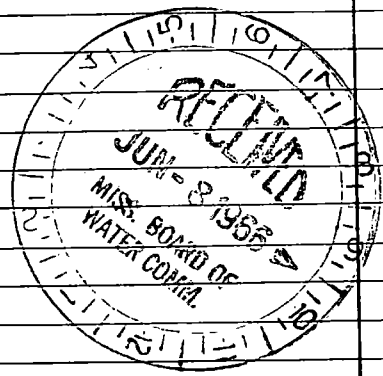

Mail this copy to Board of Water Commissioners 429 Miss. St. Jackson, Miss.

